


DATE _____

TOWN OF LEXINGTON — BOARD OF PUBLIC WORKS

WATER DIVISION

Sketch of Service Here

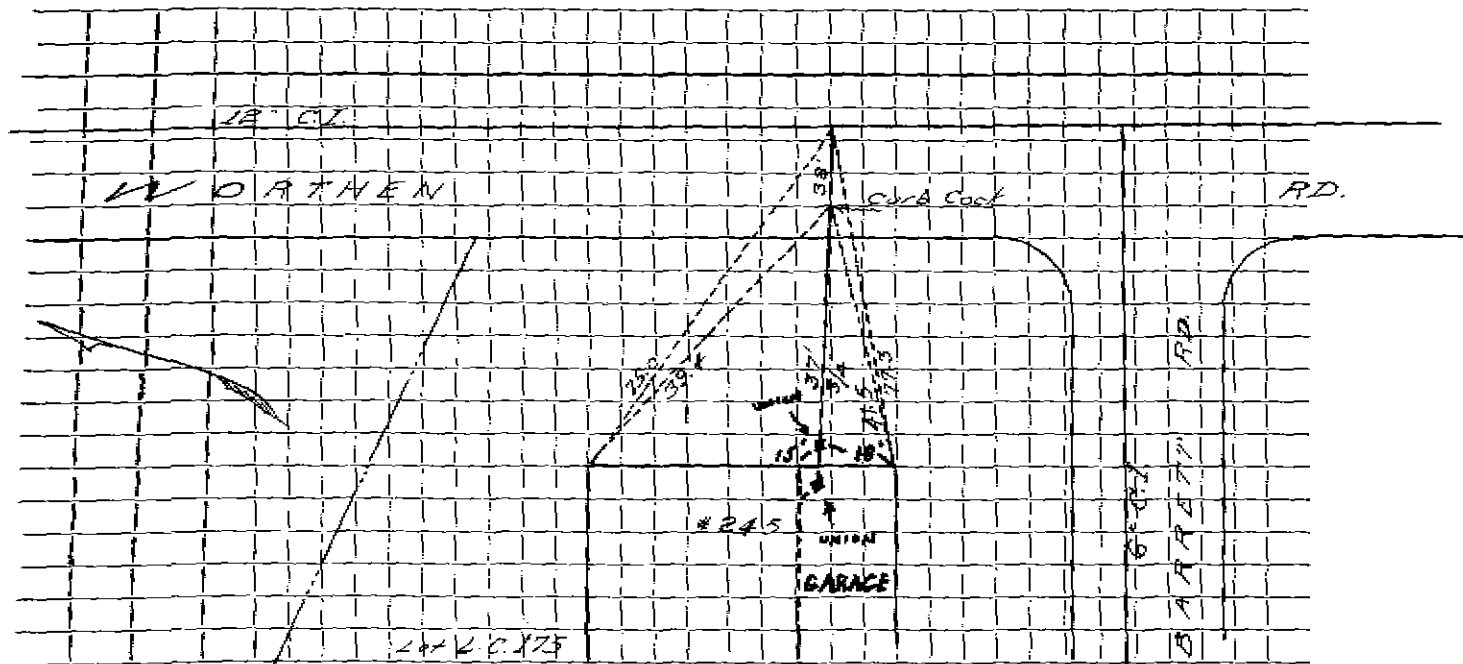

Connection made in _____ Street _____ Work completed _____

Remarks: 6/8/94. Contractor. 2-1/4 unions 6' 3/4 copper. Union inside garage over sewer 1' inside wall. Union outside wall. (Garage closed in.)