


DATE _____

TOWN OF LEXINGTON -- BOARD OF PUBLIC WORKS

WATER DIVISION

#12 RD. BARRETT

Sketch of Service Here

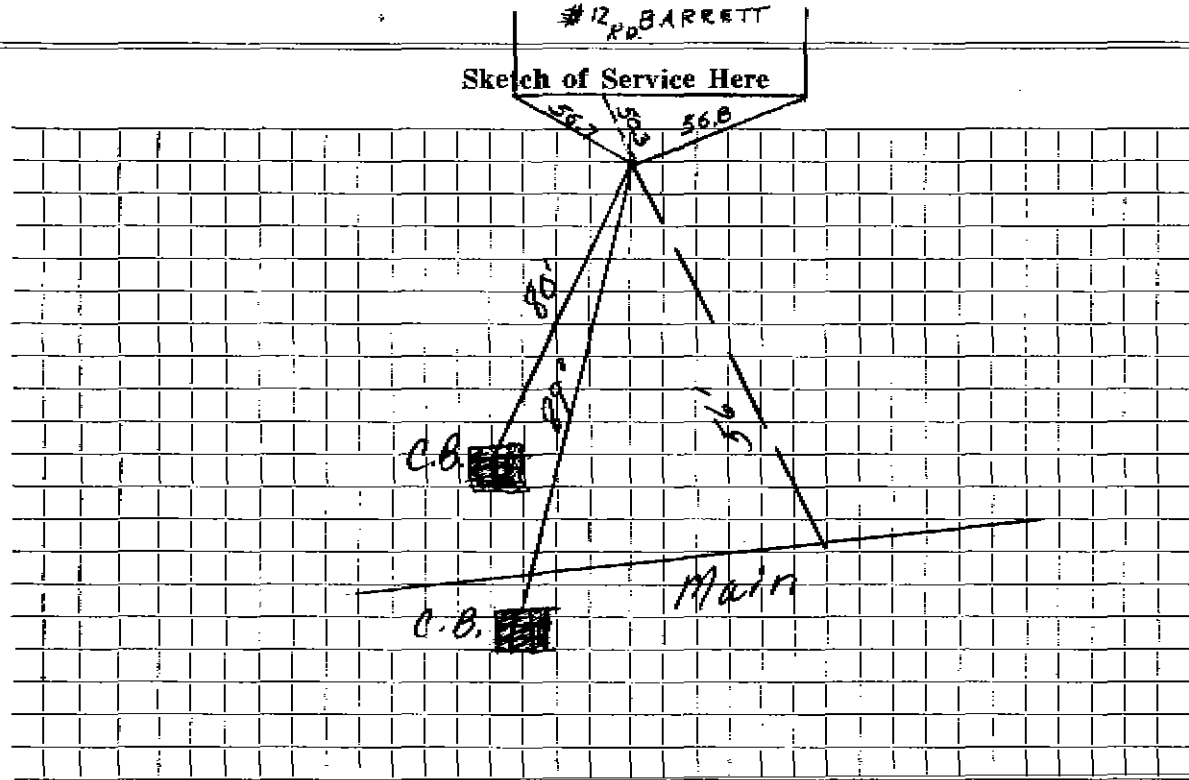

Connection made in Street. Work completed

Remarks:

.....

.....