




DATE \_\_\_\_\_

TOWN OF LEXINGTON - BOARD OF PUBLIC WORKS

**WATER DIVISION**

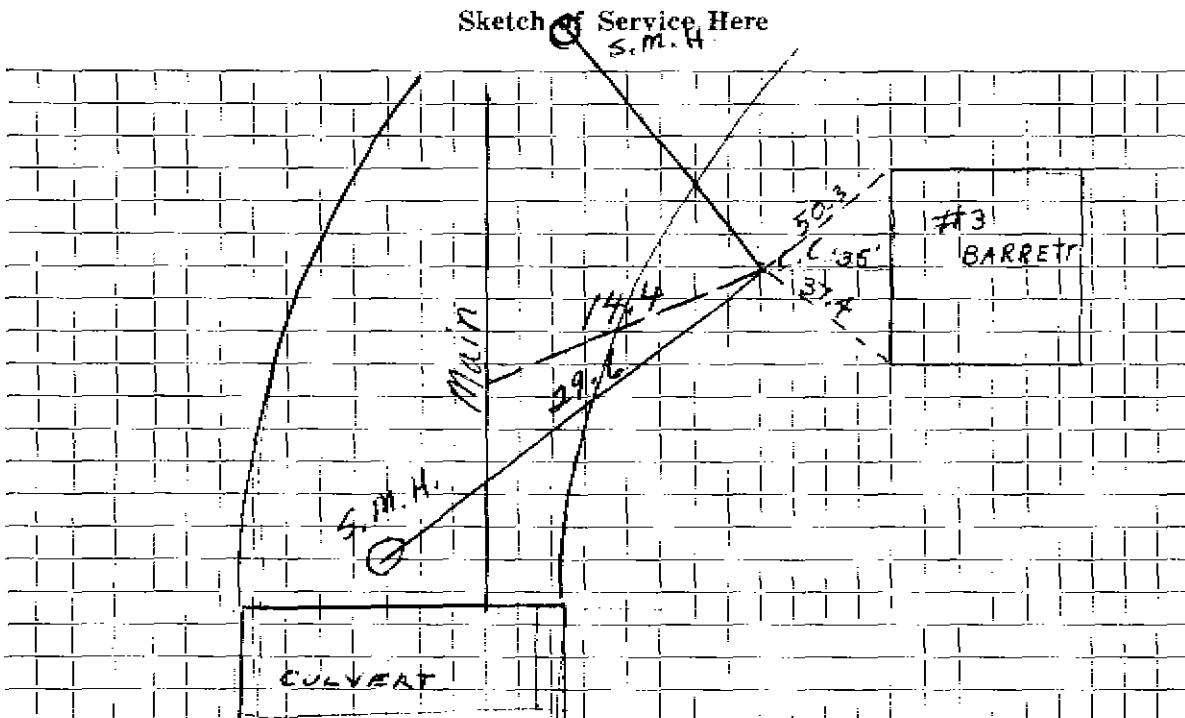

Connection made in ..... Street. Work completed .....

Remarks: .....

.....