

WATER SERVICE RECORD

Name *Herbert McConchie*

Service No.

Address *1 Barrymeade dr.*

Location

~~Repair-Renewal~~ - New Service


Comm. June 7, 1948

Date	Material	Amount	Total	Date		Amount
4/20/48	Labor	4.00		<i>Apr 7, 48</i>	<i>Deposit</i>	<i>50.00</i>
	10% O.H.	.40	4.40	<i>Jun 10 48</i>	<i>Refund</i>	<i>2.71</i>
47'	3/4" Copper tubing @.255		11.99			<i>47.29</i>
1	3/4" C x 1/2" I.W.H.S & W		3.15		OUTSIDE	
	Littlefield Shovel 1 hr. @ 7.00	7.00	7.00	4/20/48	Labor	2.50
	Trucking 1 hr. @ .75		.75	27"	3/4" Copper tubing @.225	6.89
	Patching 20 x 3		20.00	1	3/4" C Corp Cock	3.00
			47.29	1	3/4" C x 3/4" C Curb cock	3.68
				1	Box & Rod	3.50
				1/2	hr. Littlefield Shovel @7.00	3.50
				1	1/2" Offset Tailpiece	.30
				1	1/2" Straight tailpiece	.30
				1	hr. @ .75	.75
						24.42

DATE _____

TOWN OF LEXINGTON — BOARD OF PUBLIC WORKS
WATER DIVISION

Sketch of Service Here

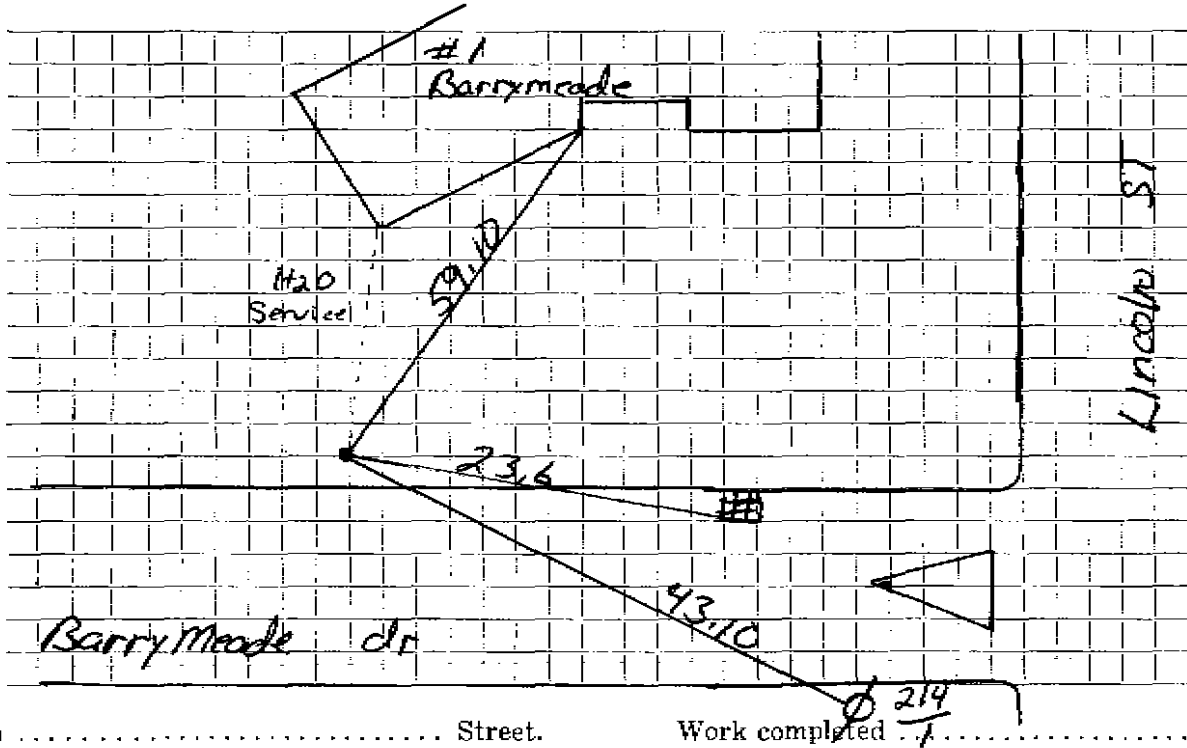

Connection made in Street. Work completed $\frac{214}{1}$

Remarks:

.....

.....