

WATER SERVICE RECORD

1098

6632

Service No. 8

Name Charles Esterberg

Address 10 Barrymeade Drive

Location Lexington

~~REPAIR WORK~~ - New Service COM.2-16-53


| Date | Material | Amount | Total | Date | Amount |
|---------|-----------------------------------|--------|-------|---------|-----------------------------------|
| 1/26/53 | Labor | 10 29 | | 1-12-53 | Deposited 75 00 |
| | 10% overhead | 1 03 | 11 32 | 2-16-53 | Refunded 4 58 |
| | 60' -3/4" Copper Tubing @.34 | | 20 40 | | NON CHARGE 20 47 |
| | 1-3/4" Cx 1/2 I.W.H. Stop & Waste | | 4 00 | 1/26/53 | Labor 10 29 |
| | 4 Hr. Littlefield Shovel | | 28 00 | | 15' -3/4" Copper Tubing @.34 5 10 |
| | 1 Hr. Trucking | | 75 | | 1-3/4" C. Corp-cock 4 33 |
| | Patching 6 x 3 | | 6 00 | | 1-3/4" Cx 3/4" C. Curb-cock 4 67 |
| | | | 70 47 | | 1- Box & Rod 3 90 |
| | | | | | 1-1/2 offset Tail Piece 50 |
| | | | | | 1-1/2 Straight tail piece 50 |
| | | | | | 1 Hr. Littlefield Shovel 7 00 |
| | | | | | 1 Hr. Trucking 75 |
| | | | | | 37 04 |

DATE _____

TOWN OF LEXINGTON — BOARD OF PUBLIC WORKS

WATER DIVISION

Sketch of Service Here

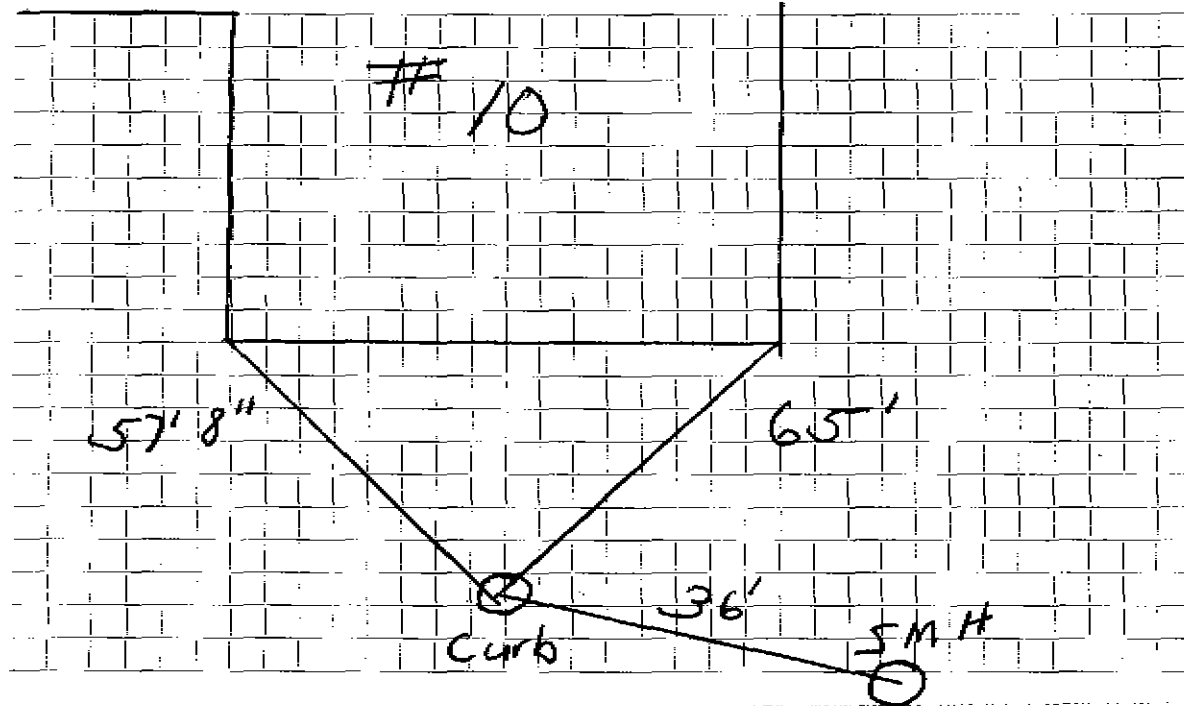

Connection made in Street. Work completed

Remarks:

.....

.....