




TOWN OF LEXINGTON — BOARD OF PUBLIC WORKS  
DATE \_\_\_\_\_

**WATER DIVISION**

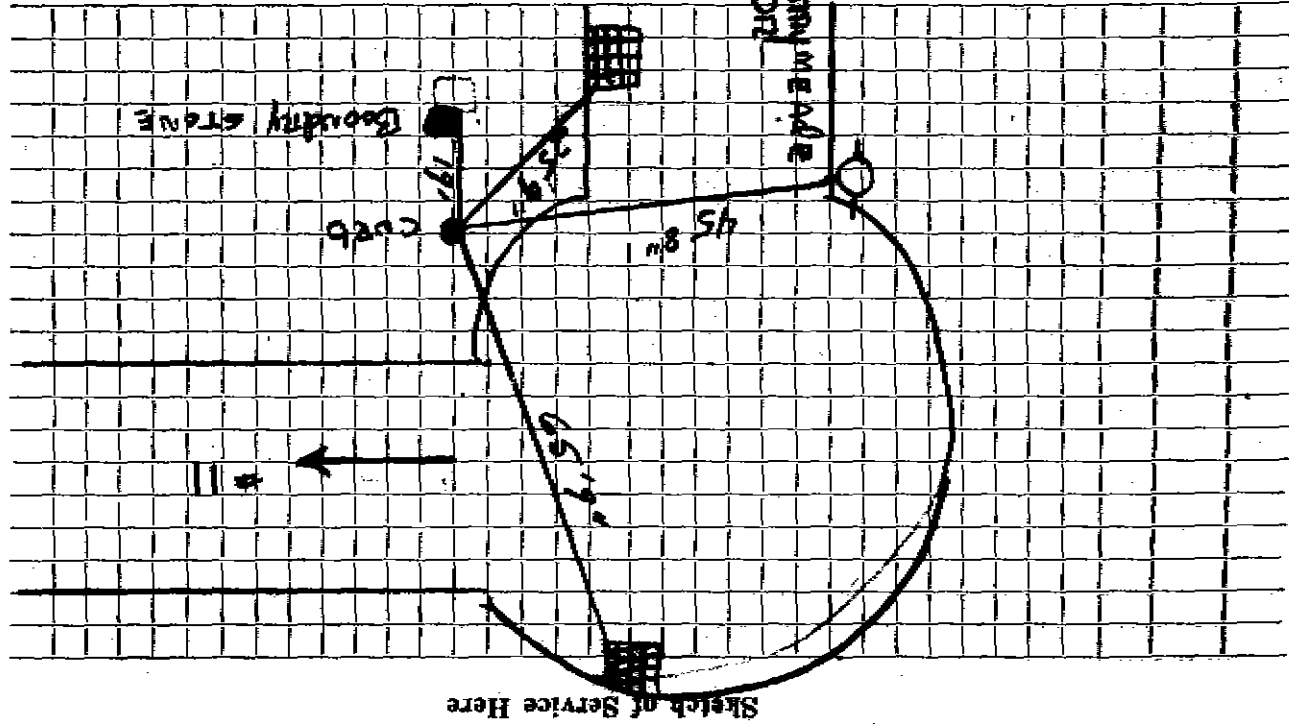

Connection made in \_\_\_\_\_

Remarks: \_\_\_\_\_

Work completed \_\_\_\_\_