
Water Service Record							
Name					Service No.	Service No.	
Address  2	BARRYMEADE DR				F		
	KINGTON, MA						
Repair - Genewa) - New Service							
Date	Material	Amount	Total	Date		Amount	
6/29/22	1" Type K Copper						
	I" CURSSTOP						
	ORN-RIGHT						
	BUFFALO BOX						
				·			
2017 2018 2018 2018				·			
	884 ;						
Digital and the		T -					

Date: 6/29/22

## TOWN OF LEXINGTON - BOARD OF PUBLIC WORKS WATER DIVISON

## SKETCH OF SERVICE HERE

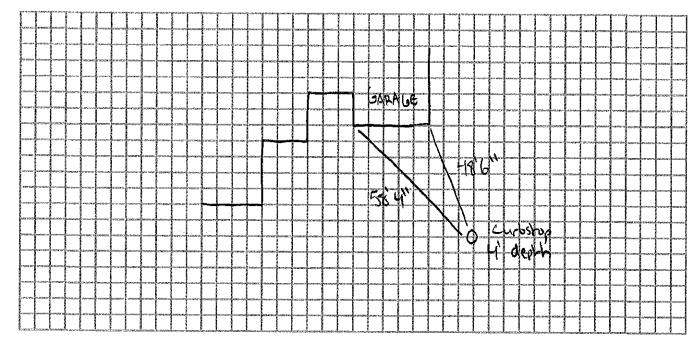

Connection made in:	Street.	Work completed:
Remarks: INSTALLED By Mc LAUGHL	1N	нанишиминановинтовируюченний при сили выстанований полительной выстановить выстановить выпусков выстановительн
<b>,</b>		ланы шини жана жана жана жана жана жана жана ж
«Вильнующий самиры принивання выбрасности и принивання в принивання в принивання в принивання в принивання в пр	DEN GRANT REPERT REPORTED BY A STREET HER	пиридення организации при при при при при при при при при п
чинининия мененининининининининининининининининини	инин и портинуваний при	зорожновинят готвъящиния мунуюнати пятовя ининиволюмия наружения польтания примения проденения проденения прим -
У масто шилин пом инизабай(бо) избурунунын максим иним курорым Барусурунунын или или или или или или или или ил	MBAN ANCHENERALIJA (ERACE) IZ PAJA JAKO BERSARI AN ANTRES ANTA ANTRA ANTRA JAKO	анды дөмөлөн алын алын алын алын алын алын алын алы