

Name Walter Bragdon

Service No. 109 32 32

Address 22 Barrymeade Drive

Lexington, Mass.

Location 22 Barrymeade Drive

Kind of Pipe

Size

Size of Main

~~Repair-Removal~~—New Service

*Com 12.30.46*

Location

Date

Material

Amount

Total

Date

Amount

Dec. 9, '46

Labor

16 25

16 25

10% Overhead

1 63

46' - 3/4" Copper Tubing @.27

12 42

1 - 3/4" C x 1/2" I.W.H. S & W

2 82

Trucking 1 hr. @.75

75

Patching 3' x 3'

3 00

36 87

Part of trench Dug By Owner

Labor

*Nov. 29, '46*

*Dec 31 '46*

*Deposited  
Refunded*

50 00

13 13

Non-Charge

36 87

Dec. 7, '46 Labor

9 03

9, '46 "

4 85

10' - 3/4" Copper Tubing @.27

2 70

1 - 3/4" C Corp-cock

2 70

1 - 3/4" C x 3/4" C Curb-cock

3 30

1 - Box & Rod

3 50

Trucking 1 hr. @.75

75

1 - 1/2" Straight Tail Piece

50

1 - 1/2" Offset Tail Piece

50

27 83

DATE \_\_\_\_\_

# TOWN OF LEXINGTON—BOARD OF PUBLIC WORKS

## WATER DIVISION

The undersigned applies for a supply of water at No. \_\_\_\_\_ St. and hereby agrees to comply with the rules and regulations as now, or at any future time, established by the Board of Selectmen.

Am't. of Estimate \$ \_\_\_\_\_


Owner \_\_\_\_\_

Am't. Paid \$ \_\_\_\_\_

Address \_\_\_\_\_

Builder \_\_\_\_\_

Sketch of Service Here

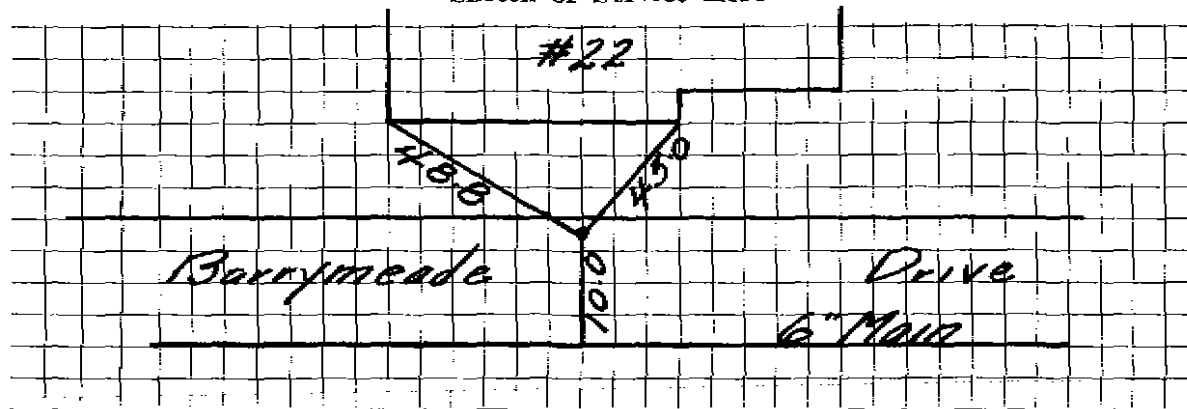

Connection made in \_\_\_\_\_ Street.

Work completed \_\_\_\_\_ 19

Remarks: