

WATER SERVICE RECORD

17969

Name Roy Aalerud

Service No. 284

Address 3 Barrymeade Drive

Location

Repair/Replacement - New Service

Comm. 12-3-56


Date	Material	Amount	Total	Date	Amount
9/18/56	Labor	18 57		9-14-56	Deposit \$100 00
	10% Overhead	1 86	20 43	12-3-56	Refund 2 10
	60 3/4" Copper tubing@.4850	29 10			<u>97 90</u>
	1 - 3/4" C x 1/2 I.W.H. stop&waste	4 96			<u>NON CHARGE</u>
	1 hr. trucking@.75	75			Labor 3 80
	2 2/3 hrs. Littlefield shovel @3.50	22 66			24' - 3/4" Copper tubing@.4850 11 64
	20 x 3 patch	20 00	97 90		1 - 3/4" C. corp-cock 4 64
					1 - 3/4" C. curb-cock 5 94
					1 box and rod 4 62
					1 1/2 straight tail piece 50
					1 1/2 offset tail piece 50
					2 hrs. Littlefield shovel@3.50 17 00
					<u>48 64</u>

DATE \_\_\_\_\_

TOWN OF LEXINGTON — BOARD OF PUBLIC WORKS

WATER DIVISION

Sketch of Service Here

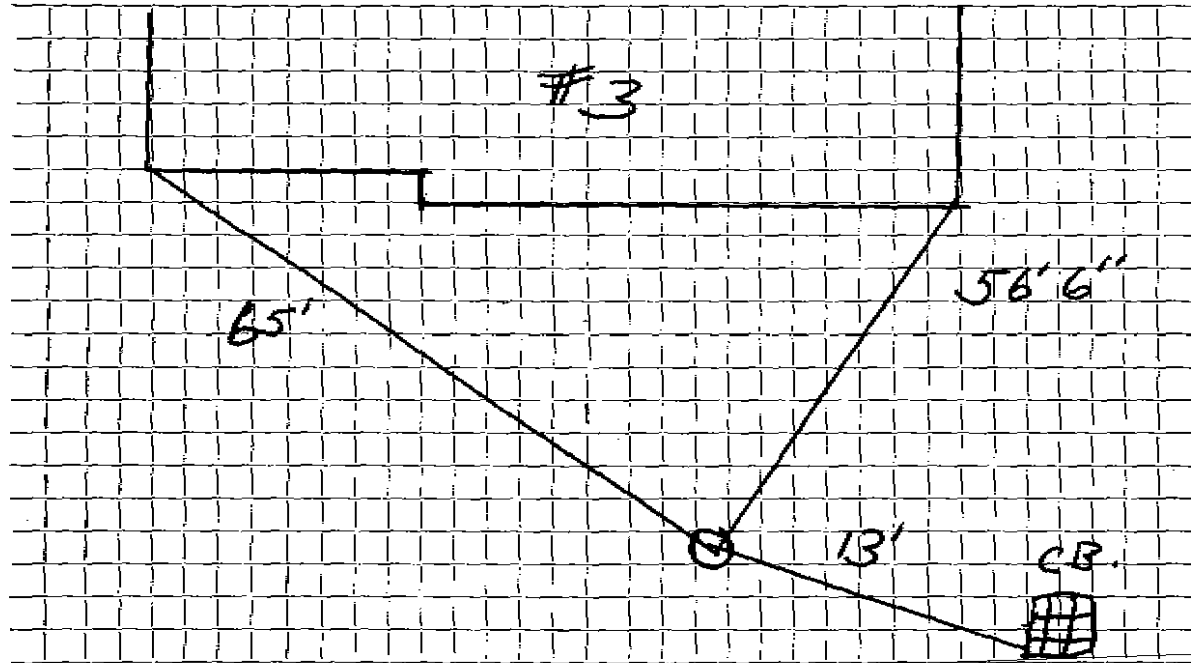

Connection made in ..... Street. Work completed .....

Remarks: .....  
.....  
.....