

WATER SERVICE RECORD

Name Joseph Chisholm

Service No. 382

Address 5 Barrymeade Drive

2858

Location

~~XXXXXX~~ New Service

Com. 12-31-55


Date	Material	Amount	Total	Date	Amount
12/6/55	Labor	36 37		11-29-55	Deposited \$ 235 00
	10% overhead	3 64	40 01	12-31-55	Refunded 26 95
	150' 1" copper tubing @ .645	96 75			NON CHARGE 206 95
	1 - 1" Cx3/4" I.W.H. Stop & Waste	4 50		Labor	7 40
	2 - 1" Unions (3 parts) @ 2.26	4 52		30' 1" copper tubing @ .645	19 35
	20x3 patching	20 00		1 - 1" C. Corp cock	5 61
	4- 2/3 hrs. Ltfld. Shovel @ 8.50	39 67		1 - 1" C. curb cock	4 67
	2 hrs. trucking @ .75	1 50		1 box & rod	3 90
			206 95	1 - 3/4" straight tail piece	50
				1 - 3/4" offset tail piece	50
				2 hrs. Ltfld. Shovel @ 8.50	17 00
				1 hr. trucking	75
					59 68

DATE _____

TOWN OF LEXINGTON — BOARD OF PUBLIC WORKS

WATER DIVISION

Sketch of Service Here

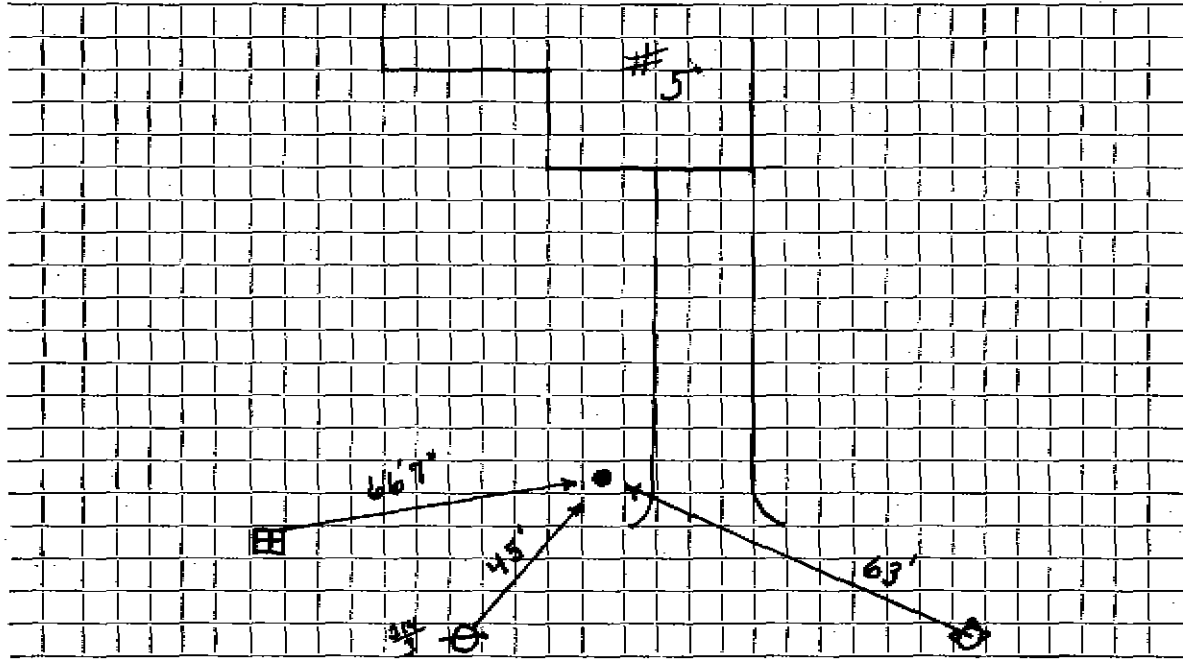

Connection made in Street. Work completed

Remarks:

.....

.....