

WATER SERVICE RECORD

Name John Stennes

Service No. 269

Address 8 Barrymeade Drive

7243

Location Lexington

~~READY TO BE~~ - New Service

Com. 11-24-52


Date	Material	Amount	Total	Date	Amount
10/14/52	Labor	3 19		10-9-52	Deposited 225 -
	10% overhead	52	3 51	11-24-52	Refunded 4 74
	50' - 3/4" copper tubing@.34		17 00		NON CHARGE 30 26
	1 -3/4" C x 1/2 I.W.H. stop& waste		4 00	10/14/52	Labor 9 57
	1 hr. trucking		75		10' - 3/4" copper tubing@.34 3 40
	patching 5 x 3		5 00		1 -3/4" C.corp-cock 4 33
			30 26		1 -3/4" C x 3/4" C.curb-cock 4 67
	TRENCH DUG BY OWNER				1 box and rod 3 90
					1 -1/2 straight tail piece 50
					1 -1/2 offset tail piece 50
					1 hr. littlefield shovel 7 00
					1 hr. trucking 75
					34 62

DATE _____

TOWN OF LEXINGTON — BOARD OF PUBLIC WORKS

WATER DIVISION

Sketch of Service Here

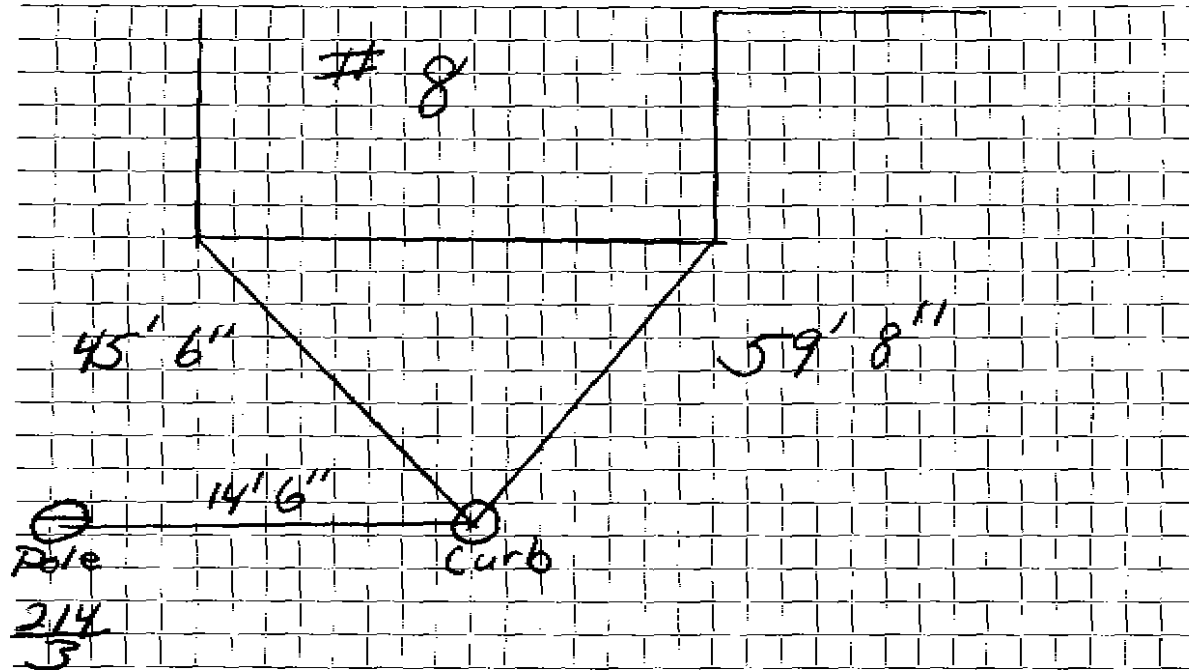

Connection made in Street. Work completed

Remarks:

.....

.....