

WATER SERVICE RECORD

Name I. W. Stephens

Service No. 12

Address 11 Bartlett <sup>Ave.</sup> Road (Mail--146 Washington St., Arl.)

# 2099

Location

Repairs ~~Renewal~~ - New Service

Comm. 6-10-57


Date	Material	Amount	Total	Date	Amount
5/1/57	Labor	2 04		2-21-57	Deposit # 50 00
	10% overhead	20	2 24	6-10-57	Refund 22 02
	42 3/4" Coppertubing @.4228		17 76		# 27 98
	1 3/4"C x 1/2 I.W.H. Stop & Waste		4 96		<u>NON CHARGE</u>
	1 Union 3 Part		2 27	Labor	2 04
	1 Hr. trucking @.75		75	31 3/4" Copper tubing @.4228	13 11
			27 98	1 3/4"C Corp Cock	4 64
				1 3/4"C Curb Cock	5 94
				1 Box & Rod	4 62
				1 1/2 Straight tail piece	50
				1 1/2 Offset tail piece	50
					31 35

DATE \_\_\_\_\_

TOWN OF LEXINGTON — BOARD OF PUBLIC WORKS

WATER DIVISION

Sketch of Service Here

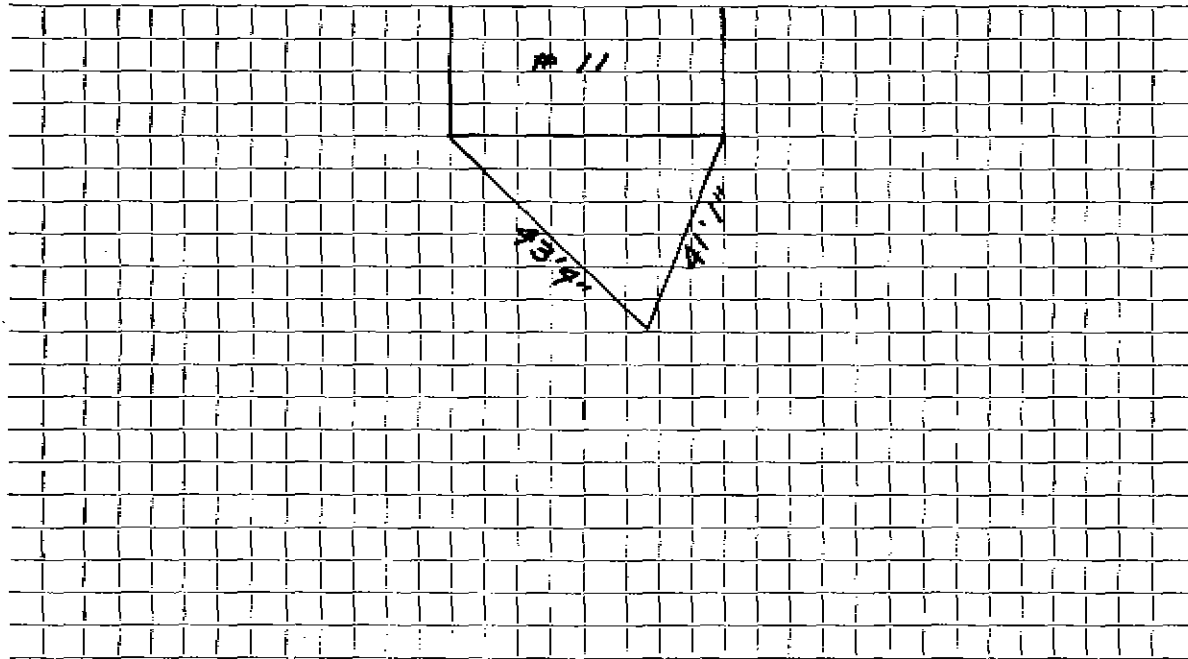

Connection made in ..... Street. Work completed .....

Remarks: .....  
.....  
.....