

Name
Address

Service No. 91
#1552

Location 15 Bartlett Ave.

Kind of Pipe

Size

Size of Main

~~Repair~~—Renewal—~~New Service~~

Location

Date	Material	Amount	Total	Date	Location	Amount
8-9-'73	Labor	\$136.80		8-16-'73	Labor	\$62.52
NON-CHARGE	10 % O.H.	13.68	\$150.48	NON-CHARGE	10% O.H.	6.25
	2 Hrs. Truck @3.00	6.00			3 Hrs. Trucking@3.00	9.00
	2 Hrs. Town Shovel @6.50	13.00			1 Hr. Compressor	5.00
	17' 3/4" Copper Tubing @.60	10.20			2 Ton Top @8.00	16.00
	1 3/4" Curb Cock	13.70				<u>\$98.77</u>
	1 1" Repair Change	5.05				
	1 1" Coupling	4.04				
	1 1" X 4" Nipple	.51				
	1 Box & Rod	7.34				
	1/4 Ton Cold Patch	2.00				
		<u>\$212.32</u>				
	Labor					

DATE _____

TOWN OF LEXINGTON—BOARD OF PUBLIC WORKS

WATER DIVISION

The undersigned applies for a supply of water at No. _____ St. and hereby agrees to comply with the rules and regulations as now, or at any future time, established by the Board of Selectmen.

Am't. of Estimate \$ _____

Owner

James Doherty


Am't. Paid \$ _____

Address

15 Bartlett ave.

Builder _____

Sketch of Service Here

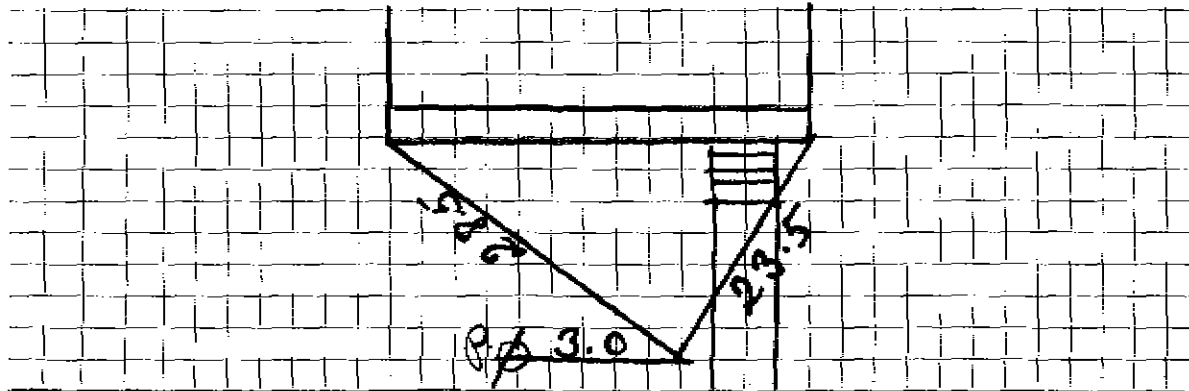

Connection made in Bartlett Street. ave Work completed _____ 19

Remarks: