

WATER SERVICE RECORD

Name Fred Antonelli

Service No. 01

Address 16 Bartlett Avenue

Location \_\_\_\_\_

Repair ~~Renewal~~ —New Service

*Comm. 6-13-55*


Date	Material	Amount	Total	Date	Amount
4/28/55	Labor	1 85		4-12-55	Deposited 25 00
	10% overhead	19	2 04	6-13-55	Refunded 1 23
	46' - 3/4" copper tubing @ .3693		16 98		NON CHARGE 2 3 77
	1 - 3/4" C x 1/2 I.W.E. stop & waste		4 00		SERVICE WAS IN TO CURB:
	1 hr. trucking		75		1 - 1/2 straight tail pc. 50
			23 77		1 - 1/2 offset tail pc. 50
					1 00

DATE \_\_\_\_\_

TOWN OF LEXINGTON — BOARD OF PUBLIC WORKS

**WATER DIVISION**

Sketch of Service Here

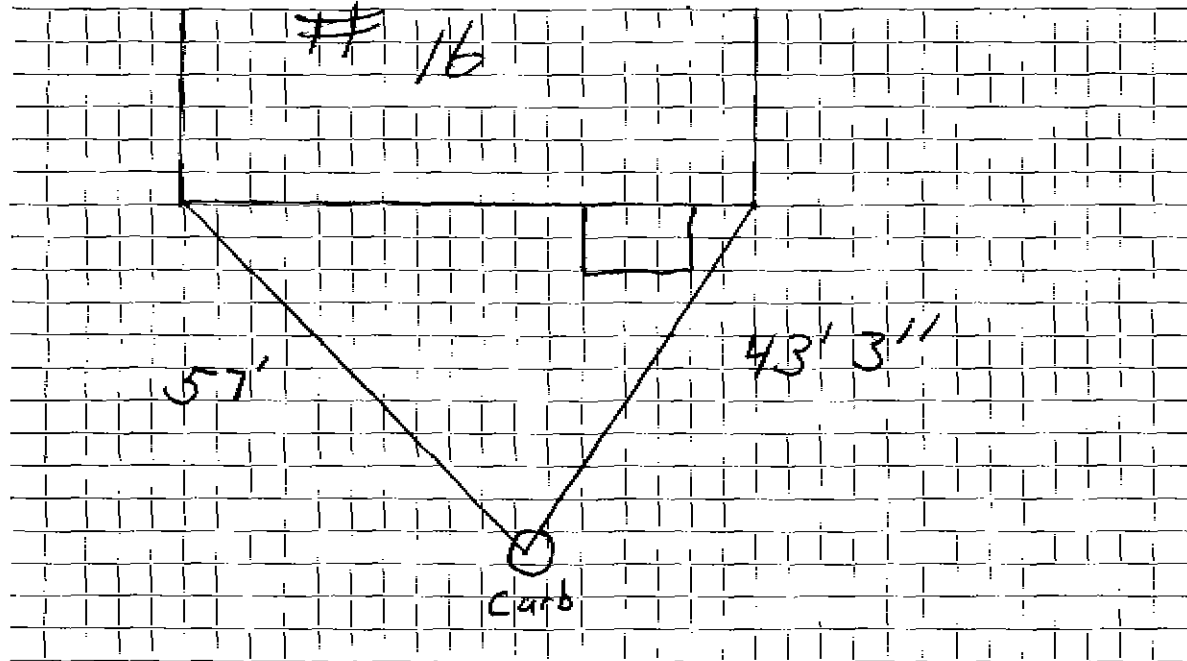

Connection made in ..... Street. Work completed .....

Remarks: .....

.....

.....