

Name John L. Craig

Service No.

Address 22 Bartlett Avenue

Lexington, Mass.

Location 22 Bartlett Avenue

Kind of Pipe Com. May 31, 1948

Size

Size of Main

~~Repair-Overhaul~~ - New Service

Location

Date	Material	Amount	Total	Date	Location	Amount
Apr. 2, '48	Labor	1 90	1 90	Mar 29 '48	Reported	80 00
	10% Overhead		19	June 3 '48	Deposited	6 85
	32' - 3/4" Copper Tubing @.255	8 16	8 16		Non-Charge	28 15
	1 - 3/4" C x 1/2" I.W.H. S & W	3 15	3 15	Apr. 2 '48	Labor	1 10
	Littlefield Shovel 2 hrs. @7.00	14 00	14 00	12' - 3/4" Copper Tubing @.255		3 06
	Trucking 1 hr. @.75	75	75	1 - 3/4" C Corp-cock		3 00
			28 15	1 - 3/4" C x 3/4" C Surb-cock		3 68
				1 - Box & Rod		3 50
				Littlefield Shovel 1 hr. @7.00		7 00
				1 - 1/2" Offset Tail Piece		30
				1 - 1/2" Straight Tail Piece		30
				Trucking 1 hr. @.75		75
	Labor					22 69

DATE \_\_\_\_\_

TOWN OF LEXINGTON - BOARD OF PUBLIC WORKS

**WATER DIVISION**

The undersigned applies for a supply of water at No..... St. and hereby agrees to comply with the rules and regulations as now, or at any future time, established by the Board of Selectmen.

Am't of Estimate \$.....

Owner .....


Am't Paid \$.....

Address .....

Builder .....

.....

Sketch of Service Here

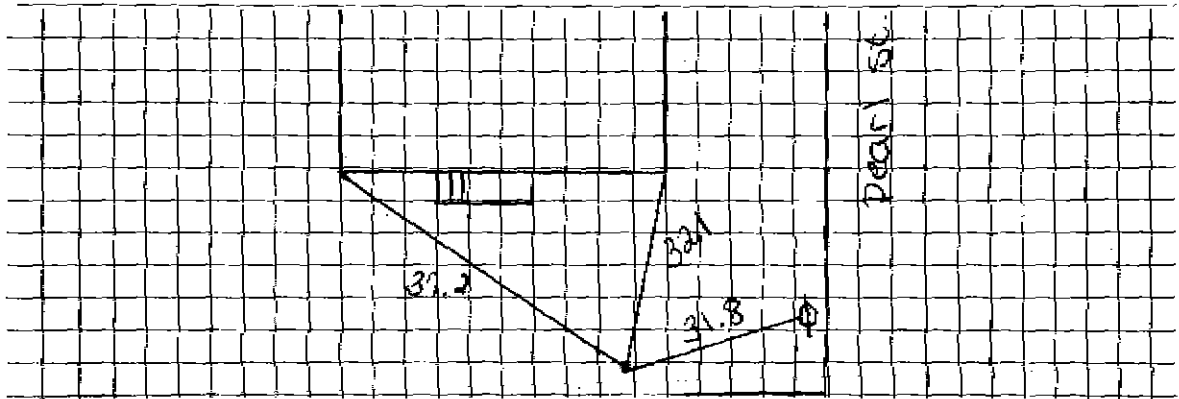

Connection made in ..... Street.

Work completed .....19

Remarks: