

Name William Stevenson

Service No. 49 93

Address 61 Spring Street, Lexington

Location

30 Bartlett Avenue

Kind of Pipe

Size

Size of Main

~~Repair—Renewal—New Service~~

Location

Date
1941

Material

Amount

Total

Date

Amount

June 20

4 hrs. @ 60¢

2 40

June 6, 1941 Deposited

15 00

10% Overhead

24

2 64

August 20, 1941 Refunded

1 72

31' 3/4" Copper tubing @ 18¢

5 89

13 28

1 3/4" G.x.1 S.S.W.

2 25

1 3/4" Bushing

25

3 hrs. tracking @ 75¢

2 25

13 28

Labor

Hadley Press, Inc., Lexington

DATE _____

TOWN OF LEXINGTON—BOARD OF PUBLIC WORKS

WATER DIVISION

The undersigned applies for a supply of water at No. _____ St. and hereby agrees to comply with the rules and regulations as now, or at any future time, established by the Board of Selectmen.


Am't. of Estimate \$ _____

Owner _____

Am't. Paid \$ _____

Address _____

Builder _____

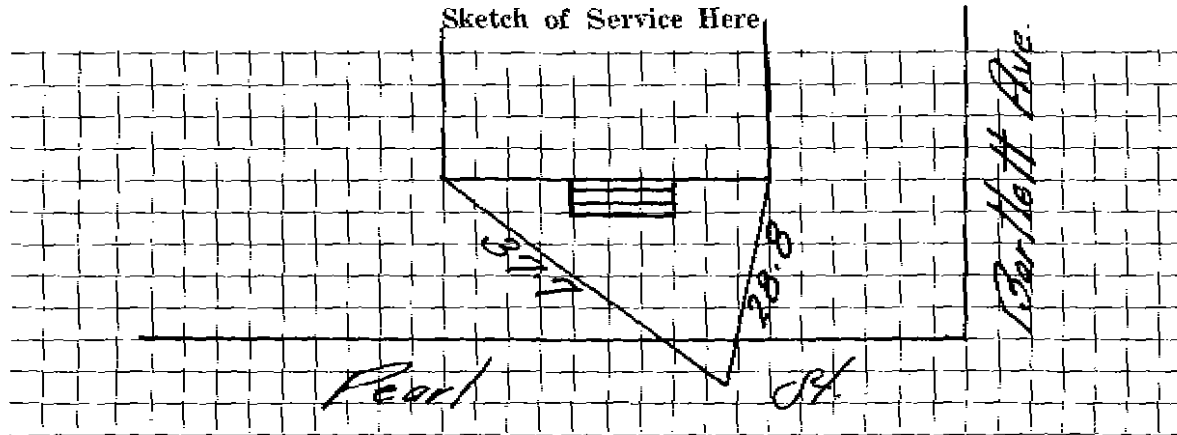

Connection made in _____ Street.

Work completed _____ 19

Remarks: