

Name Ernest Larson
 Address 31 Bartlett Avenue
 Lexington

Service No. 26

#158
 #159
 #160

Location 31 Bartlett Avenue

Kind of Pipe

Size

Size of Main

~~Repair~~ ~~Renewal~~ New Service

Com. 4-17-50

Location

Date	Material	Amount	Total	Date	Amount
Feb. 22 '50	Labor	2 70		March 10 '50	20 00
	10% Overhead	27	2 97	April 20 '50	6 09
	30'- 3/4" Copper Tubing @ 23¢		6 90		13 91
	1- 3/4" C x 1/2" W.H. S & W		3 29		
	1 hr. Trucking		75		
			13 91	Feb. 22 '50	
					43 50
					28'- 3/4" Copper Tubing @ 23¢
					6 44
					1- 3/4" C. Corp-cock
					3 15
					1- 3/4" C x 3/4" C Curb-cock
					3 85
					1 Box & Rod
					3 70
					1- 1/2" Offset Tail Piece
					38
					1- 1/2" Straight Tail Piece
					38
					3 hrs. Town Shovel
					9 00
					1 hr. Trucking
					75
					71 15
	Labor				

Deposited
Refunded

Non-Charge

TOWN OF LEXINGTON - BOARD OF PUBLIC WORKS

WATER DIVISION

The undersigned applies for a supply of water at No..... St. and hereby agrees to comply with the rules and regulations as now, or at any future time, established by the Board of Selectmen.

Am't of Estimate \$.....

Owner


Am't Paid \$.....

Address

Builder

.....

Sketch of Service Here

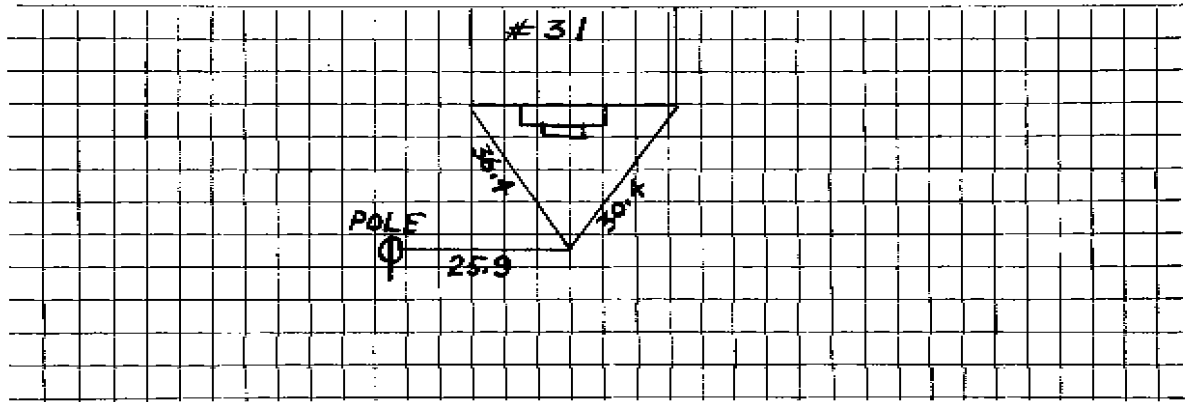

Connection made in Street.

Work completed19

Remarks: