

WATER SERVICE RECORD

Name N.Y. Brothers Trust

Service No. 29

Address 32 Bartlette Ave.

Location

Repair—Renewal—New Service

WO #2836 Defect # 2836

AUG 16 1976


Date	Material	Amount	Total	Date	Amount
6/8/76	labor	50. 48		6-8-76	125.00
	10%OH	5. 05	55. 53	8-4-76	10.00
	15' 3/4" copper tubing @ .65		9. 75		114.41
	1 3/4" corp		10. 53		
	1 3/4" curb		13. 70		
	1 box and rod		15. 40		
	1hr. truck @ 3.00		3. 00		
	1hr. shovel @ 6.50		6. 50		
			114. 41		
6/18/76	34' 3/4" Copper Tubing				

*A. [Signature]*

DATE \_\_\_\_\_

TOWN OF LEXINGTON — BOARD OF PUBLIC WORKS  
WATER DIVISION

Sketch of Service Here

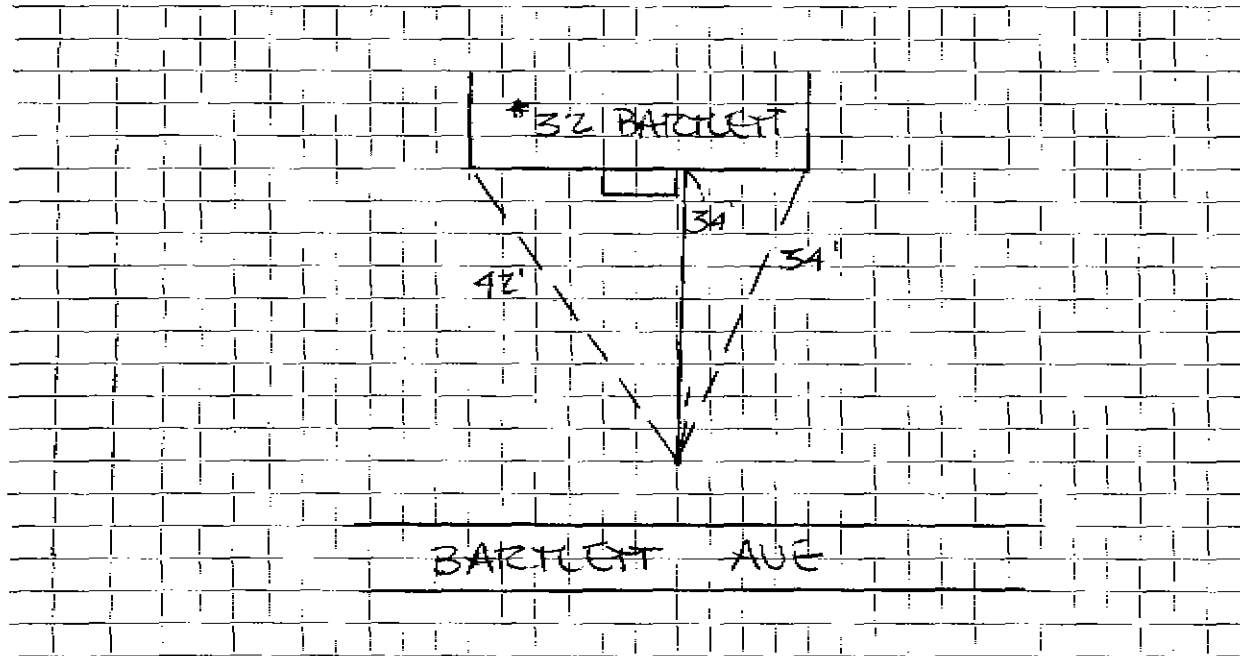

Connection made in 32 BARTLETT AVE Street. Work completed 6/18/76

Remarks: .....

.....

.....