

WATER SERVICE RECORD

Name Arnold Stocker

Service No. 327

Address 35 Bartlett Avenue

Location Lexington, Mass.

~~Repair or Renewal~~ New Service

Com. 12-26-50


Date	Material	Amount	Total	Date	Amount	
Nov. 17, '50	Labor	7 20	7 20	Oct 20 '50	130 00	
	10% Overhead		72	Nov 50	93 45	
	55' - 3/4" Copper Tubing @ .334	18 37	18 37		59 63	
	1 - 3/4" C x 1/2" I.W.H. S&W	3 76	3 76	Nov. 18, '50	Labor	11 67
	Littlefield Shovel 4 hrs. @ 7.00	28 00	28 00	30' - 3/4" Copper Tubing @ .334	10 02	
	Trucking 2 hrs. @ .75	1 50	1 50	1 - 3/4" C Corp-cock	3 60	
			59 55	1 - 3.4" C x 3/4" C Curbpcock	4 40	
				1 - Box & Rod	3 35	
				1 - 1/2" Offset Tail Piece	42	
				1 - 1/2" Straight Tail Piece	42	
				Littlefield Shovel 4 hrs. @ 7.00	28 00	
				Trucking 1 hr. @ .75	75	
					62 63	

DATE \_\_\_\_\_

# TOWN OF LEXINGTON — BOARD OF PUBLIC WORKS

## WATER DIVISION

Sketch of Service Here

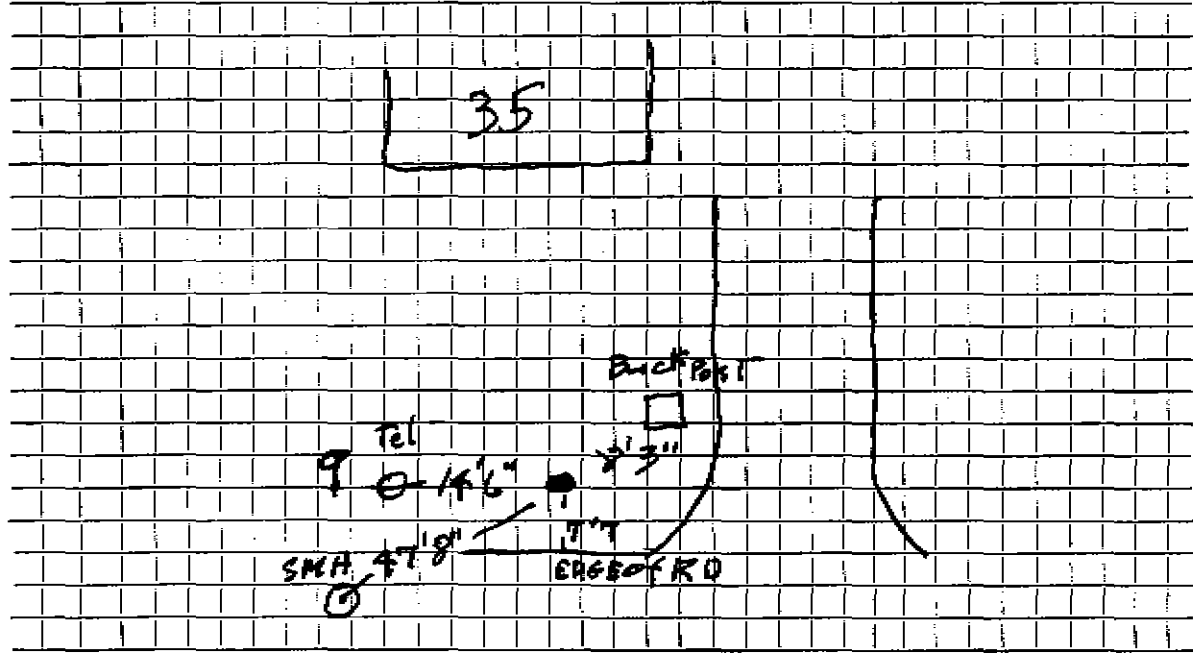

Connection made in \_\_\_\_\_ Street. Work completed \_\_\_\_\_

Remarks: \_\_\_\_\_  
\_\_\_\_\_  
\_\_\_\_\_