

WATER SERVICE RECORD

3232

Name Richard Hamilton

Service No. 281 #6298

Address #36 Lots 119 & 120 BARTLETT AVENUE

#7239

Location

~~XXXXXXXXXX~~ New Service SERVICE IN TO CURB

Comm 12-31-59


Date	Material	Amount	Total	Date	Amount
11-6-59	Labor	2.10		10-19-59 12-31-59	56.80 18.80
	10% O.H.	.21	2.31		NON CHARGE
	53' 3/4" Copper tubing @.42		22.26	10/1/53	Labor 1 90
	1 3/4"C x 1/2 I.W.H. Stop & Waste	5.88		10' - 3/4" Copper tubing @.3629	3 63
	1 hr. Trucking @.75		.75	1 - 3/4"C. corp-cock	4 33
			31.20	1 - 3/4"C x 3/4"C. curb-cock	4 67
				1 box and red	3 90
				1 hr. trucking	75
					19 18
				1 1/2 Straight tailpiece	.50
				1 1/2 Offset tailpiece	.50
					20.18

DATE _____

TOWN OF LEXINGTON — BOARD OF PUBLIC WORKS

WATER DIVISION

Sketch of Service Here

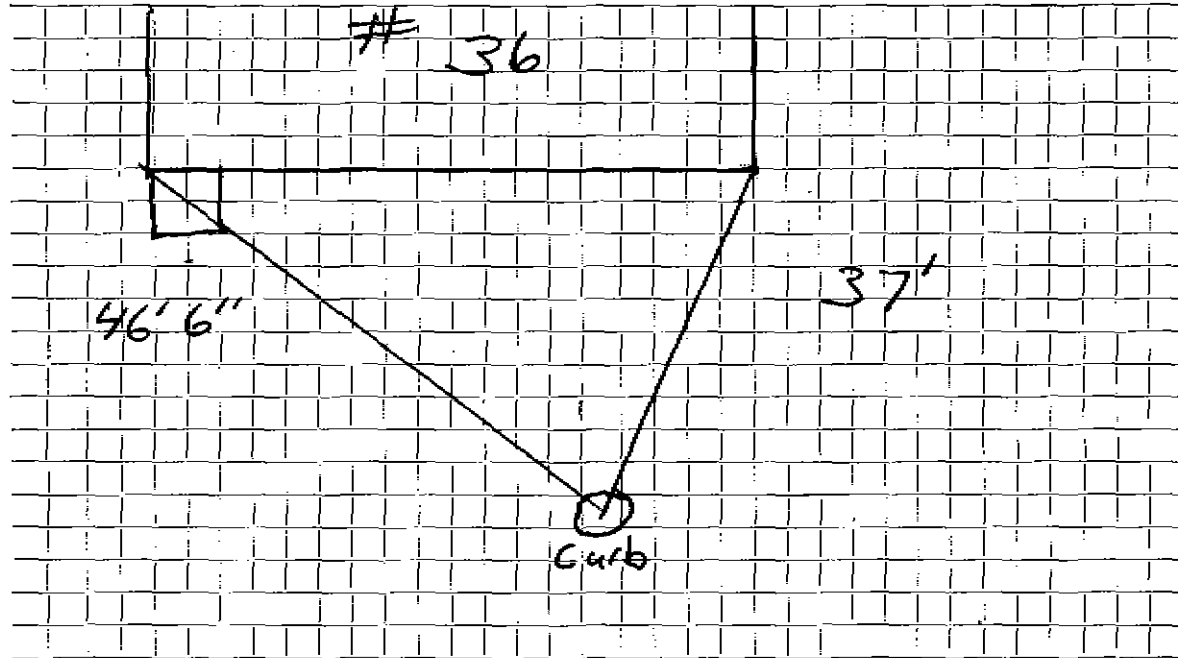

Connection made in Street. Work completed

Remarks:
.....
.....