

WATER SERVICE RECORD

Name William ~~RE~~ DeMontigny

Service No. 45

Address 41 Bartlett Avenue

Location

~~Repair~~—Renewal—~~New Service~~

W.O. # 7199

MAY 27 1969


Date	Material	Amount	Total	Date	Amount
8/15/68	Labor	82 64		8-7-68	300 00
	10% O.H.	8 26	90 90	5-27-69	134 12
	43'-3/4" Copperpipe .79		33 97		166 88
1	3/4 X 1/2" I.W.H.S.W.		12 01	9/16/53	30' 3/4 COPPER
3	Hrs. Shovel @ 6.50		19 50	1	3/4 COPE ADAPTER
2	" Trucking @ 3.00		6 00	1	3/4 CURB COCK
1	Yd. Loan		3 50		
			<u>166 88</u>		

DATE _____

TOWN OF LEXINGTON -- BOARD OF PUBLIC WORKS

WATER DIVISION

Sketch of Service Here

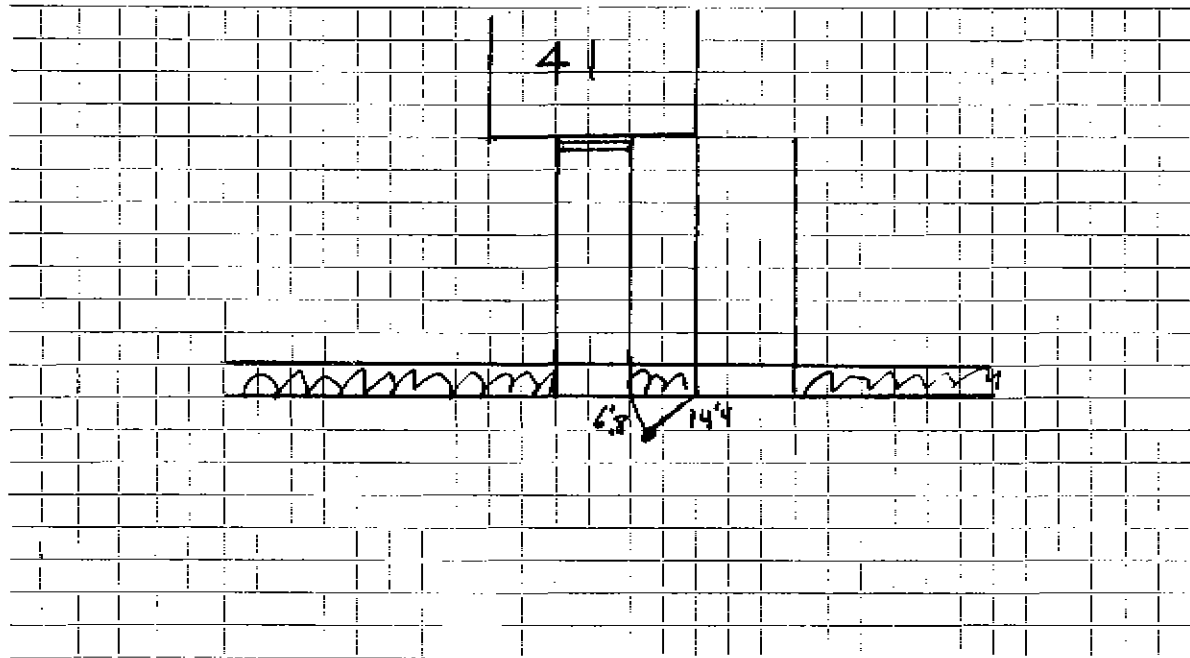

Connection made in Street. Work completed

Remarks:
.....
.....