

WATER SERVICE RECORD

Name Joseph J. LeLievre

Service No. 284

Address #42 Lots 113 & 114 Bartlett Avenue

Location

~~REWORKED~~ New Service SERVICE IN TO CURB

Comm 12-31-59


| Date | Material | Amount | Total | Date | Amount | |
|----------|------------------------------------|--------|-------|---------------------------------|------------------|-------|
| 11-19-59 | Labor | 3.86 | | 11-28-59 12-31-59 | 30.00 | |
| | 10% O.H. | .39 | 4.25 | | 16.44 | |
| | | | | | 33.56 | |
| | 54' 3/4" Copper tubing @.42 | | 22.68 | 9/30/53 | Labor | 1.90 |
| | 1 3/4" C x 1/2 I.W.H. Stop & Waste | | 5.88 | 10' - 3/4" Copper tubing @.3629 | | 3.63 |
| | 1 hr. Trucking @.75 | | .75 | 1 - 3/4" C. curb-cock | | 4.33 |
| | | | 33.56 | 1 - 3/4" C x 3/4" C. curb-cock | | 4.67 |
| | | | | 1 box and red | | 3.90 |
| | | | | 1 hr. trucking | | .75 |
| | | | | | | 19.18 |
| | | | | 1 1/2 Straight tailpiece | | .50 |
| | | | | 1 1/2 Offset tailpiece | | .50 |
| | | | | | | 20.18 |

DATE _____

TOWN OF LEXINGTON — BOARD OF PUBLIC WORKS

WATER DIVISION

Sketch of Service Here

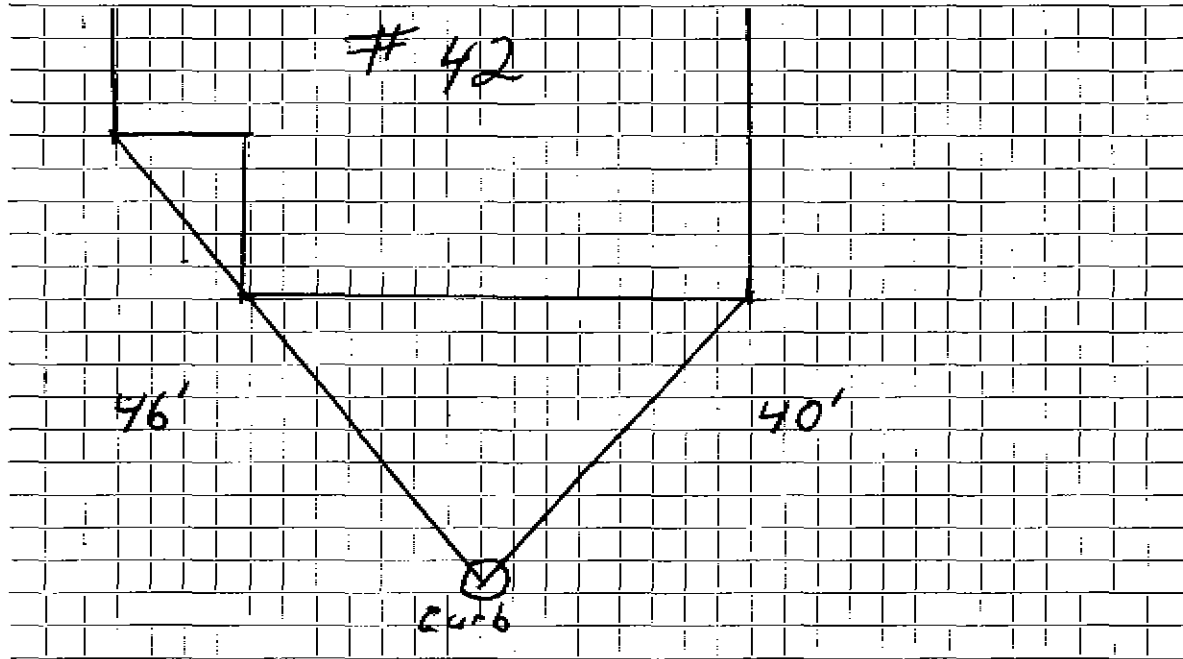

Connection made in Street. Work completed

Remarks:

.....

.....