

WATER SERVICE RECORD

Name Joseph LeLievre

Service No. 285

Address ~~44~~ ^{1114 1/2} & 110 Bartlett Avenue

Location

Repair ~~Renewal~~ - New Service SERVICE IN TO CURB

Comm 2-8-60


Date	Material	Amount	Total	Date	Amount
11-20-59	Labor	1 85		11-28-59 2-8-60	50 00 18 65
	10% O. H.	19	2 04		NON CHARGE
	54' 3/4" Copper tubing @.42		22 68	9/29/58	Labor
	1 3/4" C x 3/8 I.W.F. Stop & Waste	5 88		15' - 3/4" Copper tubing @.3629	5 44
	1 Hr. Trucking		75	1 - 3/4" C corp-cock	4 33
			31 35	1 - 3/4" C x 3/4" C. curb-cock	4 67
				1 box and rod	3 90
				1 hr. trucking	75
				11-20-59	Labor
					20 99
					1 61
				6' 3/4" Copper tubing @.42	2 52
				1 3/4" C Corp Cock	4 67
				1 3/4" C Curb Cock	5 98
				1 Box & Rod	5 00
				1 1/2 Straight Tailpiece	50
				1 1/2 Offset Tailpiece	50
					<u>41 77</u>
				<i>* Applied to SUCRAA</i>	<i>9.27</i>

DATE _____

TOWN OF LEXINGTON — BOARD OF PUBLIC WORKS

WATER DIVISION

Sketch of Service Here

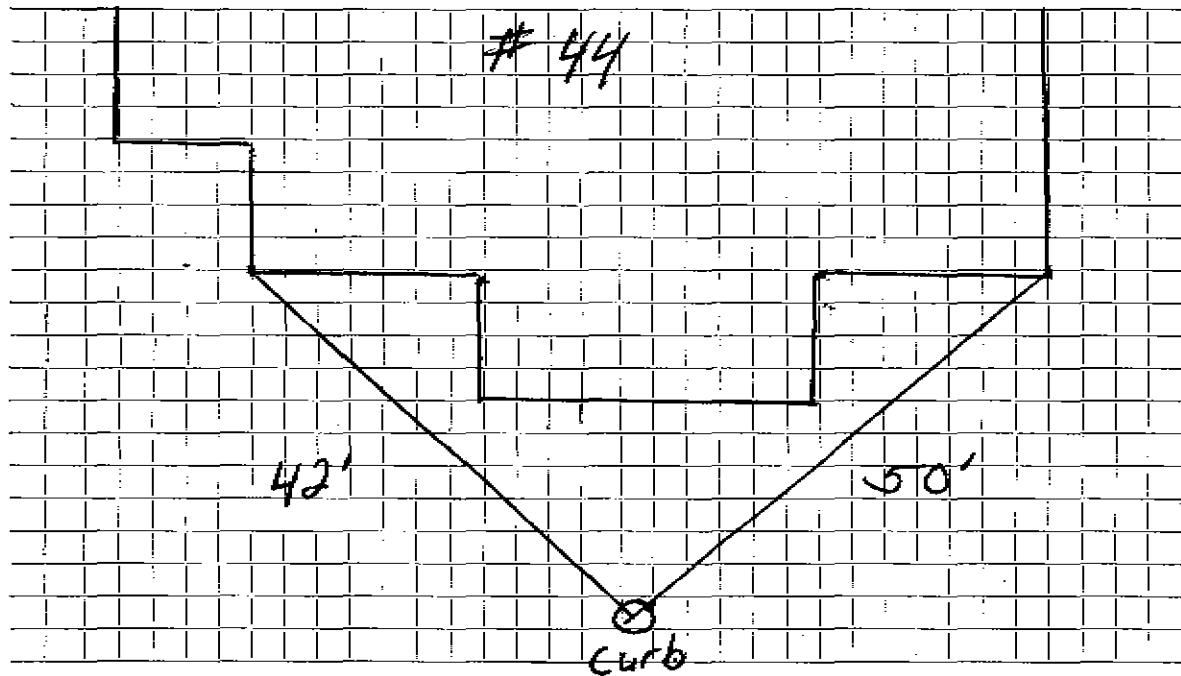

Connection made in Street: Work completed

Remarks:

.....
.....