

WATER SERVICE RECORD

Name Lexington Christian Academy

Service No.

Address 48 Bartlett Avenue

Location

~~Repair/Replacement~~ New Service Kirkland #4302


Date	Material	Amount	Total	Date	CONT. SOMERSET	Amount
11/29/85	350 3/4" Copper			1995	OUTSIDE	
	3 3/4" Comp. Unions				1" COPPER	
					1" COPP	
					1" CURB	
					1" x 3/4 union	
					Buffle Box	

DATE _____

TOWN OF LEXINGTON — BOARD OF PUBLIC WORKS

WATER DIVISION

Sketch of Service Here

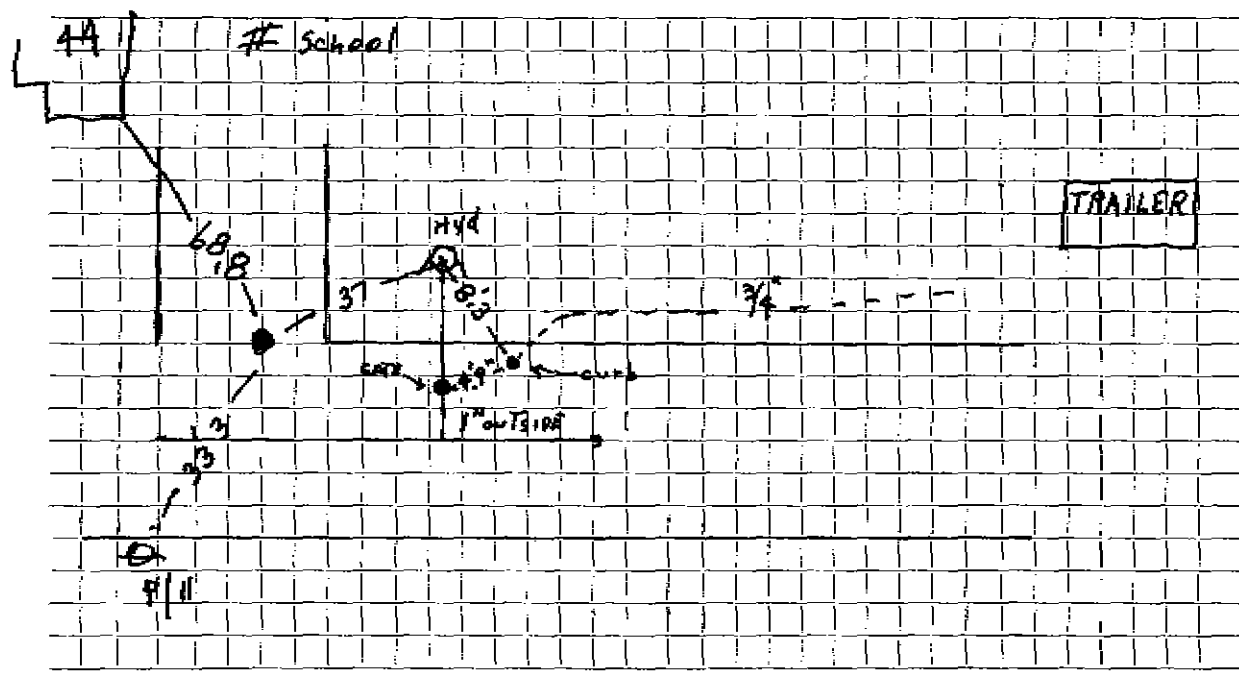

Connection made in Street. Work completed

Remarks: RENEWED w/1" outside NATIES WATER SHUT OFF 99 AT CURB

WATER SERVICE RECORD

Service No.

Name Christen High School

Address ⁴⁸ Lots #107 & 108 ⁸¹¹⁹ Bartlett Avenue #48 Bartlett Ave.

#7556

Location Christian High School

~~Repair~~ ~~Renovate~~ New Service SERVICE IN TO CURB

Date	Material	Amount	Total	Date	Amount
2/16/65	380' 4" Cast Iron pipe Everything installed by contractor				
				9/29/53	Labor 1 90
				15' - 3/4" Copper tubing @ .3629	5 44
				1 - 3/4" C. corp-cock	4 33
				1 - 3/4" Cx 3/4" C. curb-cock	4 67
				1 box and rod	3 90
				1 hr. trucking	75
					20 99

↑
New service to School
10-7-65


9/29/53	Labor	1	90
15' - 3/4" Copper tubing @ .3629		5	44
1 - 3/4" C. corp-cock		4	33
1 - 3/4" Cx 3/4" C. curb-cock		4	67
1 box and rod		3	90
1 hr. trucking			75
			20 99

This 3/4" service ~~is~~
in use. 10-7-65 FOR TRAILER

TOWN OF LEXINGTON — BOARD OF PUBLIC WORKS

WATER DIVISION

Sketch of Service Here

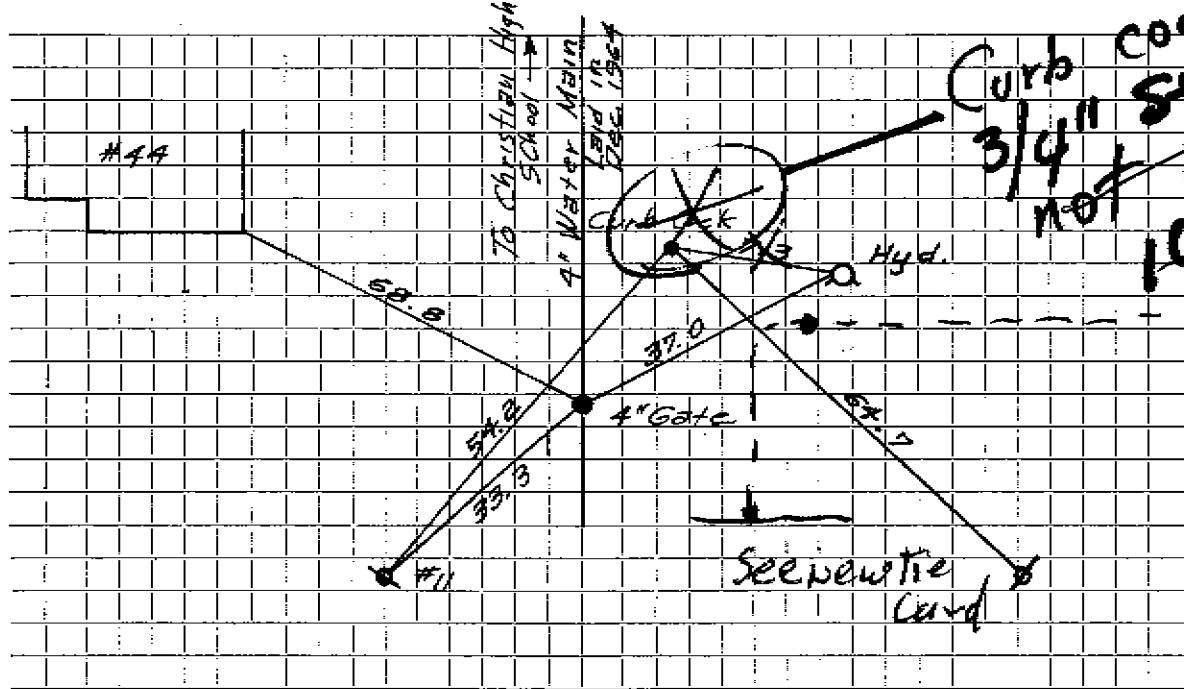

Curb cock for
~~3/4" service~~
 not in use.
 10-7-65

used for trailer
 Christian High
 11-29-85
 J W
 See other tie card

Connection made in Street. Work completed

Remarks:

