Water Service Record

Name				Service No.
Address	9 Bartlett	Avenue		

Location


Repair (Renewal) New Service

Date	Material	Amount	Total	Date	Amount
2/21/23	1" K Copper 1" Curb stop open-right	<i>3</i> 5'			
	I" Curb stop				
	open-night			es f	
	[일일하다] 이 사람들은 그 사람들이 없다.				
	Buffalo Box				

Date: 2/21/23

TOWN OF LEXINGTON - BOARD OF PUBLIC WORKS WATER DIVISON

SKETCH OF SERVICE HERE

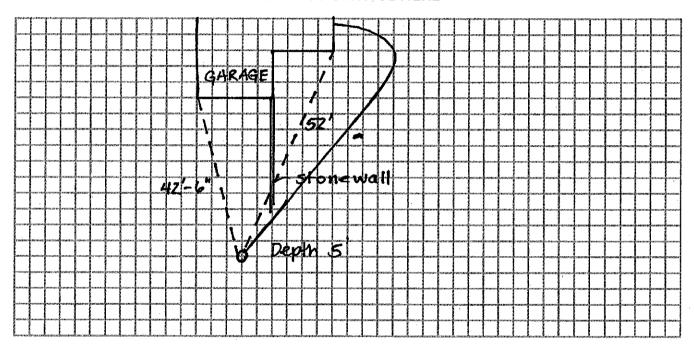

Connection made in:		Street.	Work completed:	
Remarks: Installed	by J.M	. McLaughlin	Inc.	ит или фоноволия и и возгония компония и почення выпочення выпочення выпочення выпочения выпочения выпочения в
	71			ынчинасыншынан пасыншыншыншын кантышкан шасынын комууулургын кылгын кылгыз