

WATER SERVICE RECORD

1296

Name Lexington Developing Corp.

Service No. 165

Address 1 Baskin Road

Location Lot 25

~~Repair-Roseway~~ New Service

Comm 12-31-58

Date	Material	Amount	Total	Date	Amount
8-7-58	Labor	1.91		8-4-58	35.00
	10% O.H.	.19	2.10	12-31-58	10.40
	43' 3/4" Copper tubing @.37		15.91		NON CHARGE
	1 3/4" C x 1/2 I.W.H. Stop & Waste		5.84	9/27/57	Labor @.375
	1 hr. Trucking @.75		.75	18' - 3/4"	Copper tubing
			24.60	1 3/4"	Corp Cock
				1 3/4"	C Curb Cock
				1	Box & Rod
					26.59
				1 1/2"	Straight tailpiece
				1 1/2"	Offset tailpiece
					& .50
					27.59


Apply 6.09 to SH# 137
 Balance 4.31 to Lexington Dev Corp

DATE 3/8/59

TOWN OF LEXINGTON — BOARD OF PUBLIC WORKS

WATER DIVISION

Sketch of Service Here

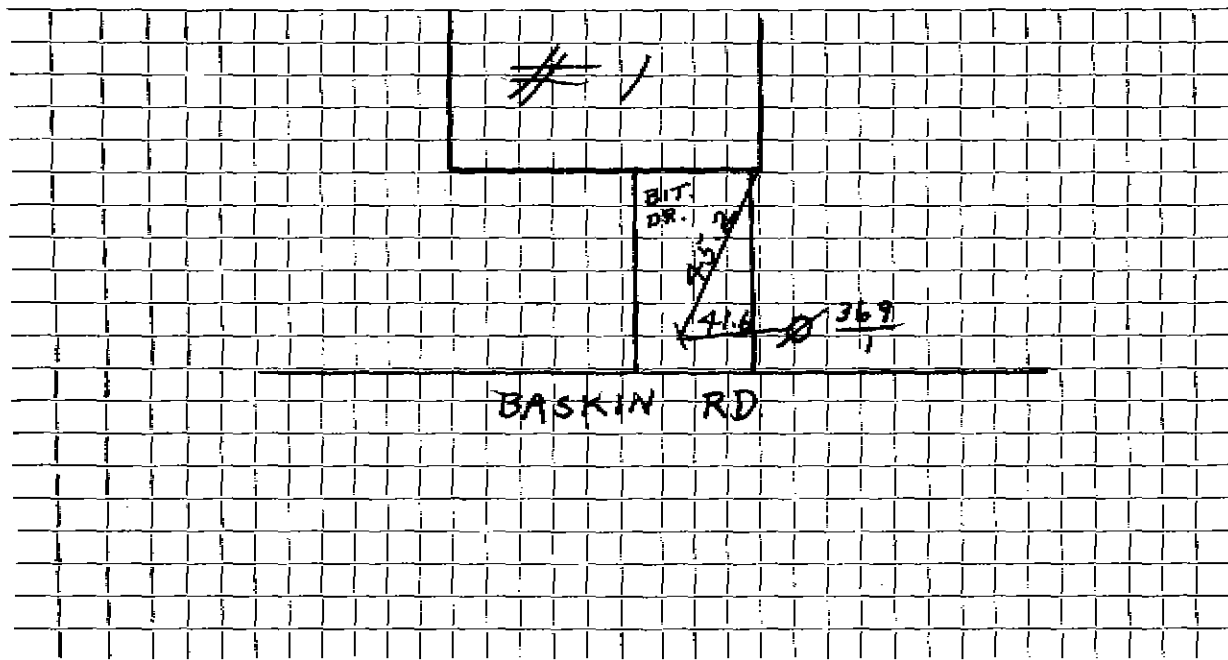

Connection made in BASKIN RD. Street. Work completed

Remarks:

.....
.....