

WATER SERVICE RECORD

Name Gene Roberts

Service No. 59

Address 11 Baskin Road

453

Location Lot 20

~~Repair - Renewal~~ - New Service

Order 10-14-58


Date	Material	Amount	Total	Date	Material	Amount
5-13-58	Labor	3.79			Deposit	35.00
	10% OH	.37	4.07	11-14-58	Refund	3.99
	55' 3/4" Copper tubing @.37		20.35		NON CHARGE	31.01
1	3/4" C x 1/2 I.W.H. Stop & Waste	5.84		9/27/57	Labor	4.64
1	hr. Trucking @.75	.75		12' - 3/4	Copper tubing	4.50
			31.01	1 3/4	C. Corp Cock	4.64
				1 3/4	C Curb Cock	5.94
				1	Box & Rod	4.62
						24.34
				5-13-58	1 1/2 Straight tailpiece	.50
					1 1/2 Offset tail piece	.50
						25.34

DATE 3/8/59

TOWN OF LEXINGTON — BOARD OF PUBLIC WORKS

WATER DIVISION

Sketch of Service Here

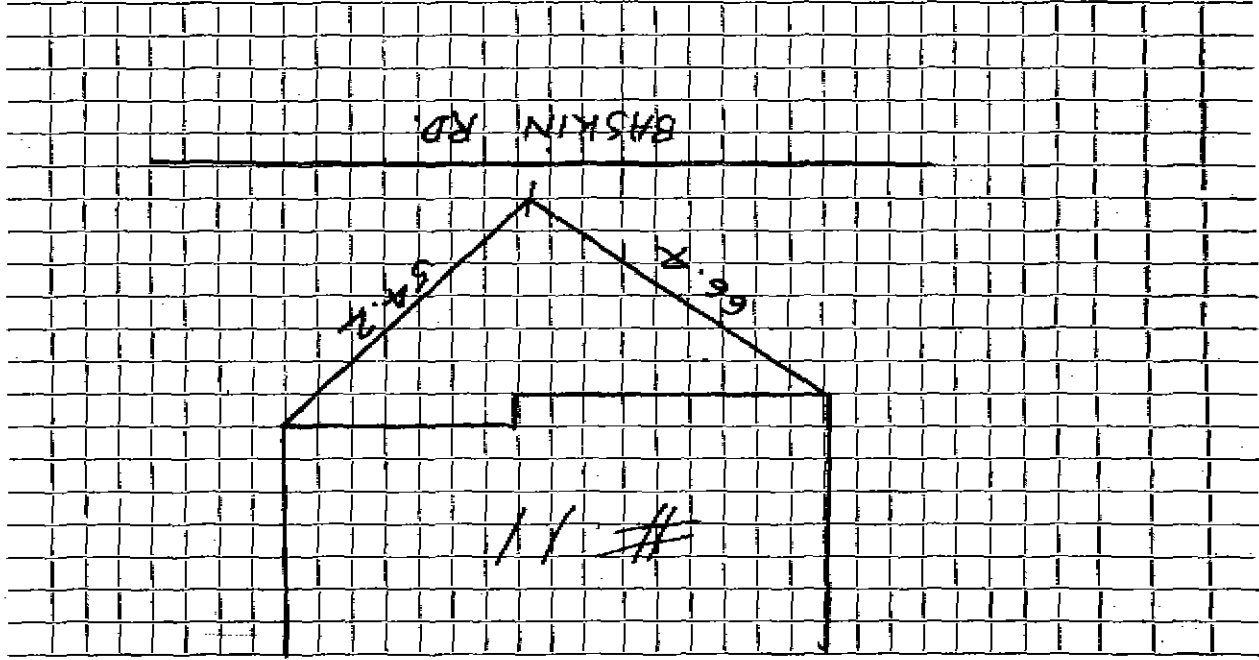

Connection made in BASKIN RD. Street. Work completed

Remarks: