

WATER SERVICE RECORD

2319-20

Service No. 97

Name Richard Magnanti

Address 12 Baskin Road

Location Lot 6

~~Repair~~ ~~Renewal~~ - New Service


Comm 11-17-58

| Date | Material | Amount | Total | Date | Amount | |
|--------|--------------------------------|--------|-------|------------|---------------------------|-------|
| 6/2/58 | Labor | 3 70 | | 5-28-58 | Deposit | 50 00 |
| | | 37 | | | | |
| | | 4 97 | 4 07 | 11-17-58 | Retard | 17 14 |
| | 60' 3/4" copper tubing @.37 | 22 20 | | | NON CHARGE | 32 86 |
| | 1 3/4" Cx 1/2 IWH stop & waste | 5 84 | | | | |
| | 1 hr. trucking @.75 | 75 | | 9/27/67 | Labor | 4 63 |
| | | | 32 86 | 38' - 3/4" | Copper tubing | 14 25 |
| | | | | 1 3/4" | C. Corp Cock | 4 64 |
| | | | | 1 3/4" | C Curb Cock | 5 94 |
| | | | | 1 | Box & Rod | 4 62 |
| | | | | | | 34 08 |
| | | | | | 1 1/2 straight tail piece | 50 |
| | | | | | 1 1/2 offset tail piece | 50 |
| | | | | | | 35 08 |

DATE 3/8/59

TOWN OF LEXINGTON — BOARD OF PUBLIC WORKS
WATER DIVISION

Sketch of Service Here

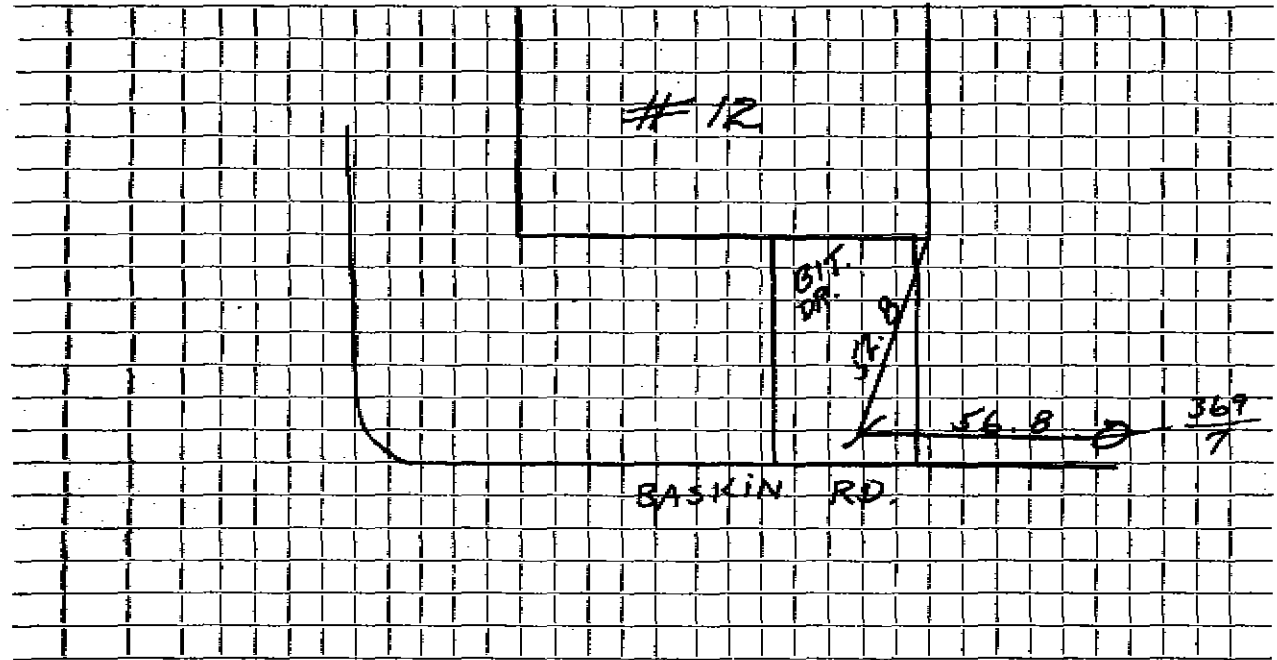

Connection made in BASKIN RD. Street. Work completed

Remarks: