




**TOWN OF LEXINGTON — BOARD OF PUBLIC WORKS**

**WATER DIVISION**

DATE \_\_\_\_\_

Sketch of Service Here

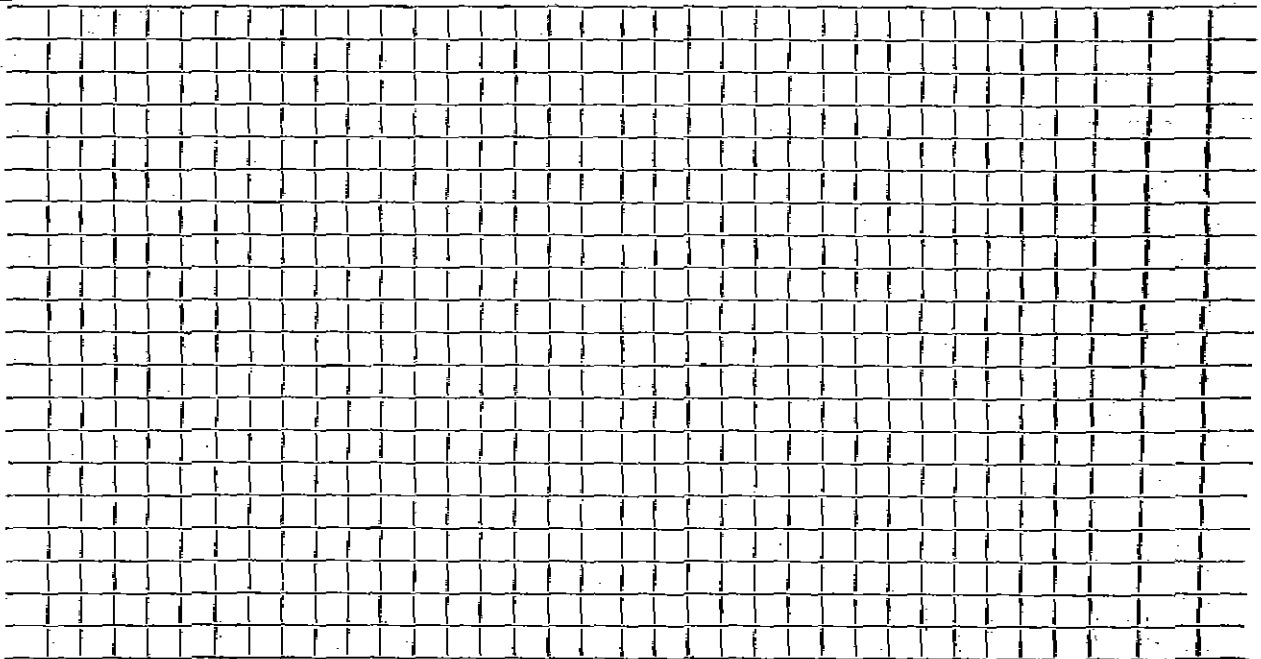

Connection made in \_\_\_\_\_

Street \_\_\_\_\_

Work completed \_\_\_\_\_

Remarks: \_\_\_\_\_