

WATER SERVICE RECORD

Name **Norman Magnanti**

Service No. 283

Address **14 Baskin Road**

Location **Lot 14**

Repair--Renewal--New Service


Comm. 3-3-58

Date	Material	Amount	Total	Date	Amount
12/27/57	Labor	3 29		12- <del>27</del> -57	Deposit \$ 50.00
	10% overhead	33	3 62	3-3-58	Refund 16.20
	50' - 3/4" Copper tubing @ .37		22 20		NON CHARGE \$ 33 80
	1 - 3/4" Cx 1/2 I.W.H. Stop & Waste		4 96	9/27/57	Labor 4 63
	1 - 3/4" C Union (3 part)		2 27	38' - 3/4" Copper tubing	14 25
	1 hr. Trucking		75	1 3/4" C Corp Cock	4 64
			33 80	1 3/4" C Curb Cock	5 94
				1 Box & Rod	4 62
					<u>34 08</u>
				1 - 1/2 Straight tailpiece	50
				1 - 1/2 Offset tailpiece	50
					<u>35 08</u>

DATE 3/8/59

TOWN OF LEXINGTON — BOARD OF PUBLIC WORKS  
WATER DIVISION

Sketch of Service Here

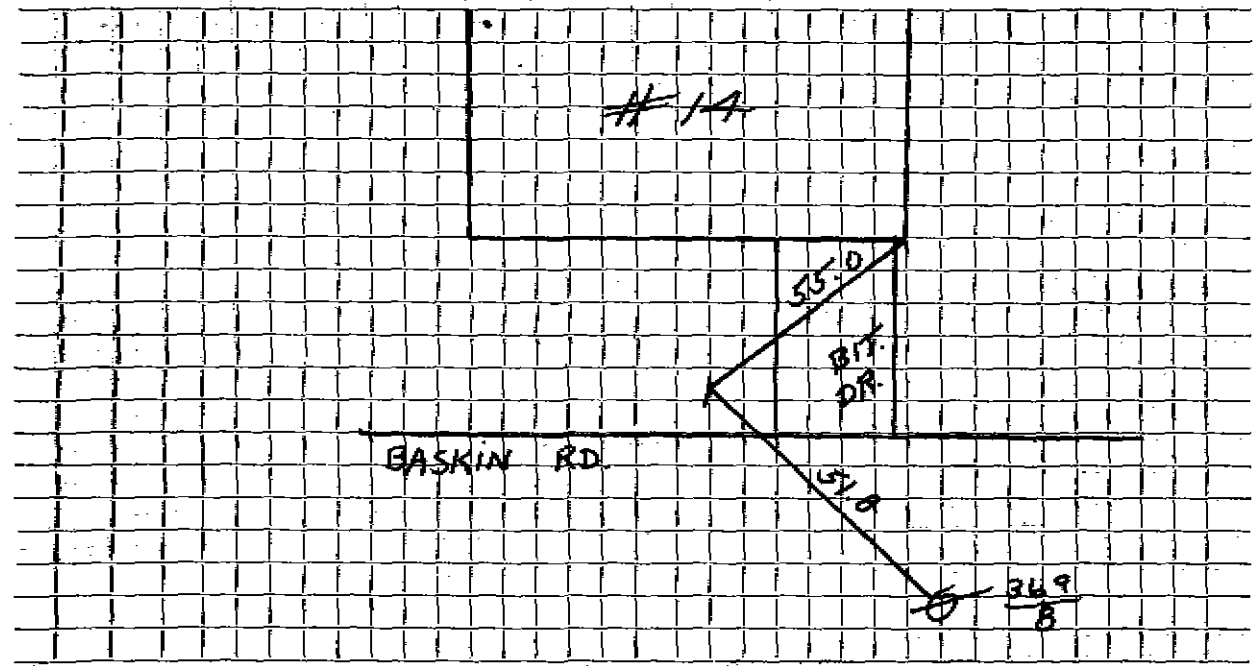

Connection made in BASKIN RD. Street. Work completed .....

Remarks: .....