

## WATER SERVICE RECORD

Name Richard Magnanti

Service No. 98

Address 15 Baskin Road

# 7754

Location Lot 18

Repair—Renewal—New Service

Comm 11-24-58


Date	Material	Amount	Total	Date		Amount
6/2/58	Labor	3 70		5-29-58	Deposited	50 00
	10% overhead	37	4 07	11-24-58	Refund	17 89
	54' - 3/4" Copper tubing @ .37		19 98		NON CHARGE	32 00
	1 - 3/4" Cx 1/2 I.W.H. Stop & Waste		5 84	9/27/57	Labor	4 64
	1 - 3/4" C. Union (3 part)		2 27	19' - 3/4" Copper tubing		7 13
	1 hr. Trucking		75	1 3/4" G Corp Cock		4 64
			32 91	1 3/4" C Curb Cock		5 94
				1 Box & Rod		4 62
						26 97
				1 - 1/2" Straight tailpiece		50
				1 - 1/2" Offset tailpiece		50
						27 97

DATE 3/8/59

TOWN OF LEXINGTON — BOARD OF PUBLIC WORKS

WATER DIVISION

Sketch of Service Here

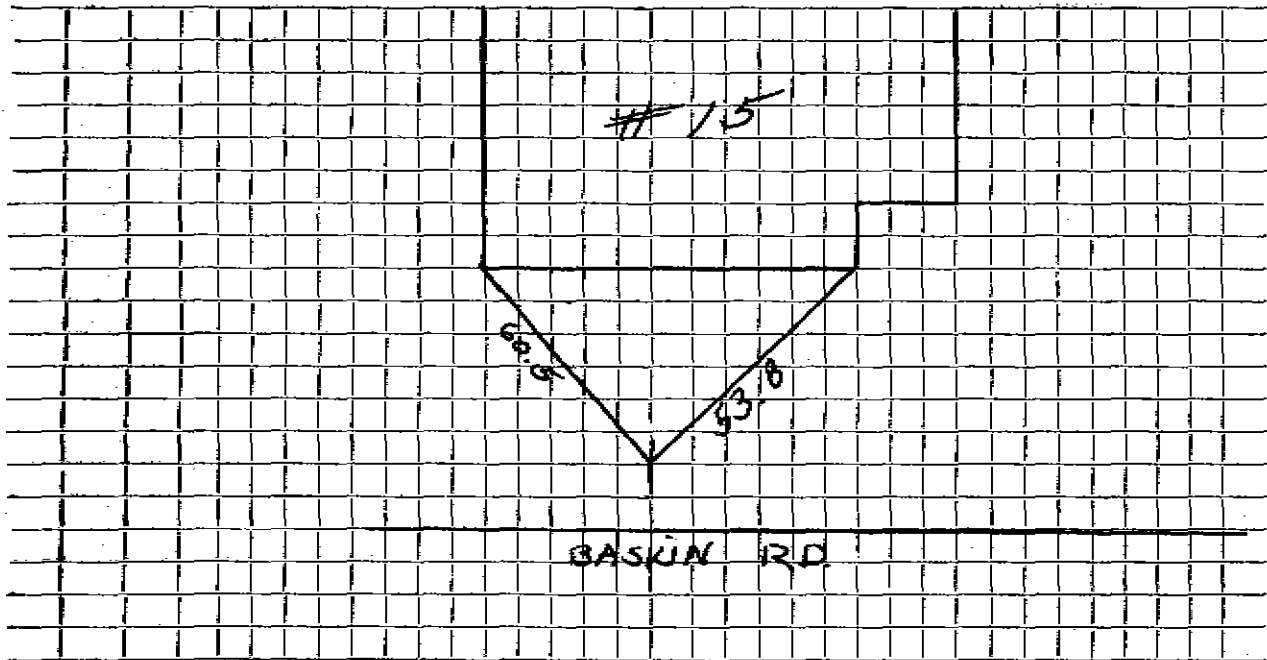

Connection made in BASKIN RD Street. Work completed .....

Remarks: .....