

WATER SERVICE RECORD

Name Richard Magnenti

Service No. 68

Address 16 Baskin Road

Location Lot B

~~Renewal~~ New Service

*Comm. 10-14-56*


| Date    | Material                         | Amount | Total | Date       | Material                        | Amount  |
|---------|----------------------------------|--------|-------|------------|---------------------------------|---------|
| 5-13-58 | Labor                            | 3.70   |       | 5-13-58    | Deposit                         | 35.00   |
|         | 10% overhead                     | .37    | 4.07  |            | Refund *                        | 2.14    |
| 60'     | 3/4" C x 1/2 I.W.F. Stop & Waste | 22.20  |       |            | NON CHARGE                      | \$32.86 |
| 1       | HP Trucking @ .75                | .75    | 32.86 | 9/27/57    | Labor                           | 4.63    |
|         |                                  |        |       | 38' - 3/4" | Copper tubing                   | 14.25   |
|         |                                  |        |       | 1 3/4"     | C Corp Cock                     | 4.64    |
|         |                                  |        |       | 1 3/4"     | C Curb Cock                     | 5.94    |
|         |                                  |        |       | 1          | Box & Rod                       | 4.62    |
|         |                                  |        |       |            |                                 | 34.08   |
|         |                                  |        |       | 5-13-58    | 1 1/2 Straight Tail piece       | .50     |
|         |                                  |        |       |            | 1 1/2 Offset Tail piece         | .50     |
|         |                                  |        |       |            |                                 | 35.08   |
|         |                                  |        |       |            | <i>* Applied to S.H.C. # 77</i> |         |

DATE 3/8/59

TOWN OF LEXINGTON — BOARD OF PUBLIC WORKS

WATER DIVISION

Sketch of Service Here

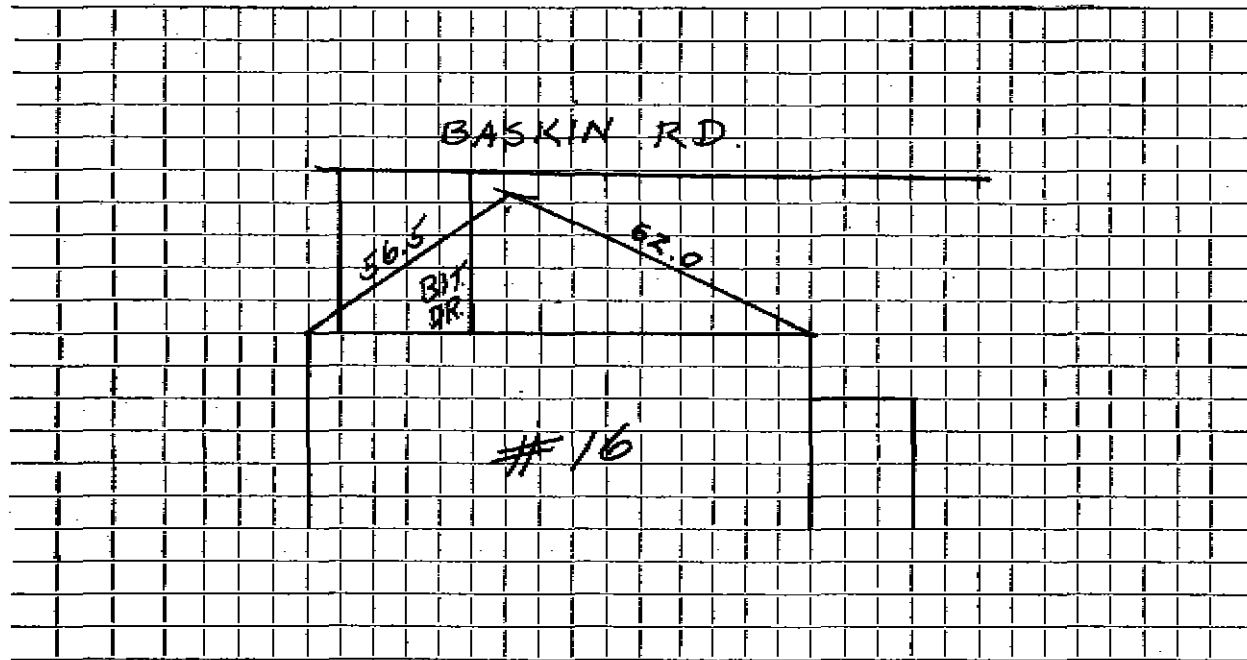

Connection made in BASKIN RD. Street. Work completed .....

Remarks: .....  
.....  
.....