

WATER SERVICE RECORD

Name **Richard Magnanti**

Service No. **214**

Address **17 Baskin Road**

2109

Location **Lot 18**

2110

-Repair--Renewal--New Service

Comm. 2/16/59


Date	Material	Amount	Total	Date	Material	Amount
10/29/58	Labor	3 46		10/16/58	Deposit	50 00
	10% overhead	35	3 81	2/16/59	Refund *	18 83
	50' - 3/4" Copper tubing @ .37	18 50			NON CHARGE	31 17
	1 - 3/4" Cx 1/2 I.W.H. Stop & Waste	5 84		9/27/57	Labor	4 64
	1 - 3/4" G Union (3 part)	2 27		11' 3/4"	Copper tubing	4 13
	1 hr. Trucking		75	1 3/4"	C Corp Cock	4 64
			31 17	1 3/4"	C Curb Cock	5 94
				1	Box & Rod	4 62
						23 97
				10/29/58	1 - 1/2 Straight tailpiece	50
					1 - 1/2 Offset tailpiece	50
					1 Box & Rod	5 00
						29 97
					Applied to Water Disc. #44	
					* Applied to Water Disc. #44	100

DATE 3/8/59

TOWN OF LEXINGTON — BOARD OF PUBLIC WORKS

WATER DIVISION

Sketch of Service Here

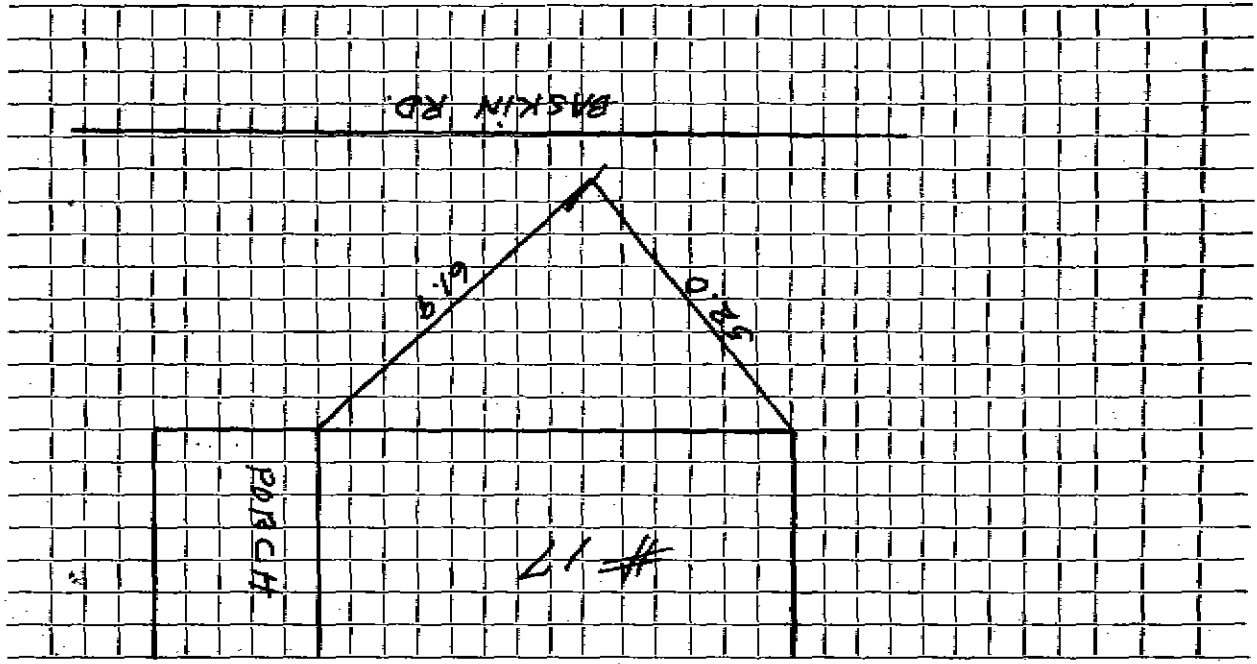

Connection made in BASKIN RD. Street. Work completed

Remarks: