




DATE 3/8/59

TOWN OF LEXINGTON — BOARD OF PUBLIC WORKS  
WATER DIVISION

Sketch of Service Here

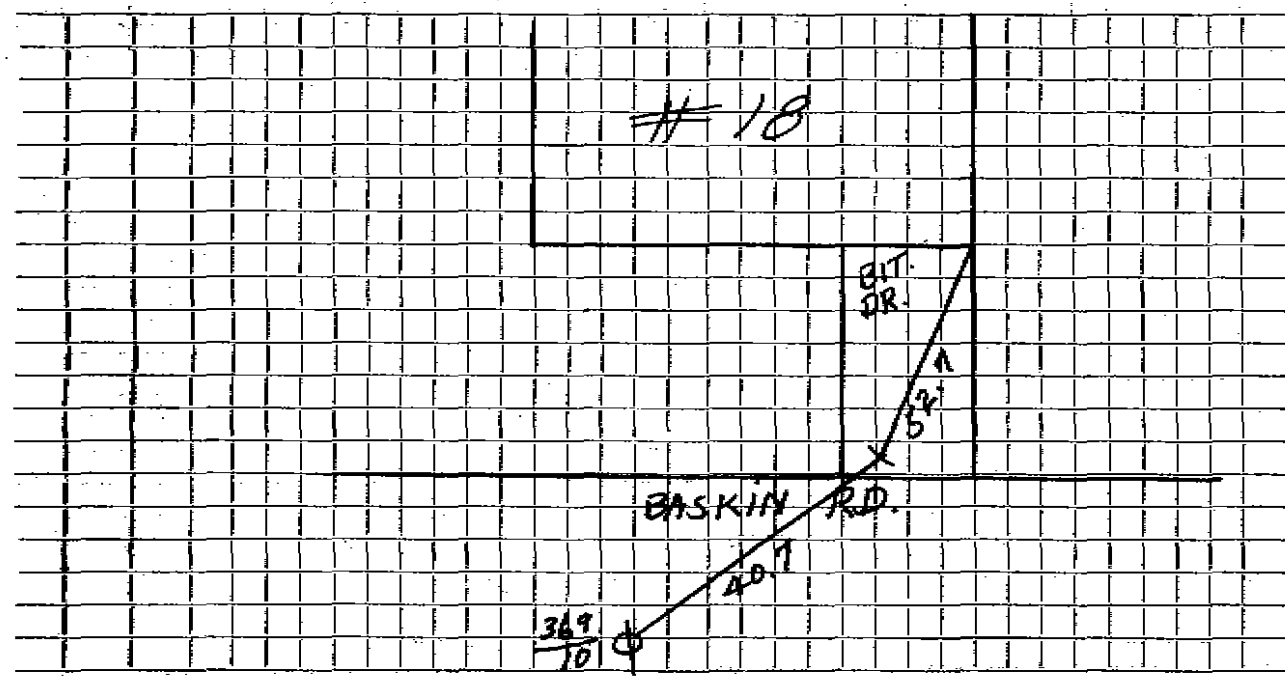

Connection made in BASKIN RD. Street. Work completed .....

Remarks: .....