

WATER SERVICE RECORD

4967

Name Custom Colonials

Service No. 770

Address 19 Baskin Road

Location Lot 26 17

Repair ~~REPAIR~~ New Service


Amount 75 00

Date				Material		Amount		Total		Date		Amount	
5-26-60				Labor		3 82				5-12-60		Deposit	
				10% O.H.		38		4 20		7-5-60		Refund	
62'				3/4" Copper tubing @.42				26 04				NON CHARGE	
1				3/4" Cx 1/2 I.W.H. Stop&Waste				6 17		9/27/57		Labor	
1				3/4" G3part Union				2 41		12' - 3/4"		Copper tubing	
								38 82		1 3/4"		C Corp Cock	
										1 3/4"		C Curb Cock	
										1		Box & Rod	
												24 34	
										1		1/2 Straight tailpiece	
										1		1/2 Offset tailpiece	
												25 34	
												2 00	
												27 00	

DATE 3/8/59

TOWN OF LEXINGTON — BOARD OF PUBLIC WORKS
WATER DIVISION

Sketch of Service Here

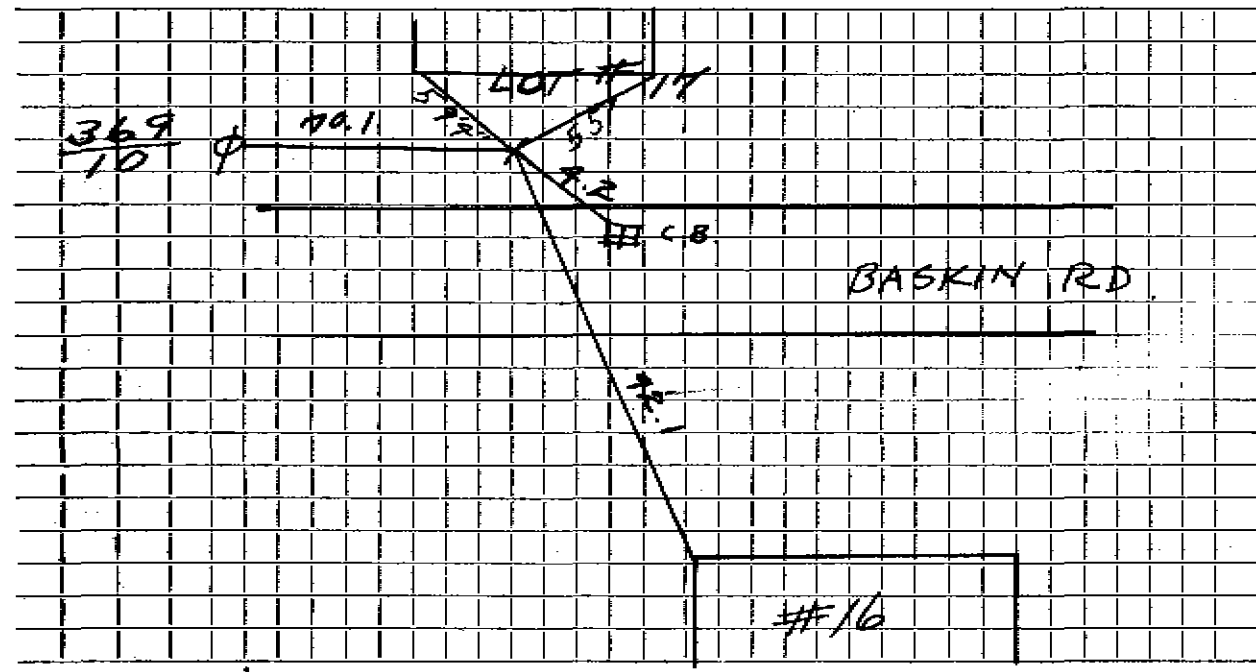

Connection made in BASKIN RD Street. Work completed

Remarks:
.....
.....