

WATER SERVICE RECORD

1415

Name Lexington Developing Corp.

Service No. 164

Address 2 Baskin Road

Location Lot 3

~~Repair Record~~ - New Service

Com 12-31-58


Date	Material	Amount	Total	Date		Amount
8-7-58	Labor	1.85		8-4-58	Deposit	35.00
	10% O.H.	.19	2.04	10-31-58	Paid by SHW 136	12.90
	100' 3/4" Copper tubing @.37		37.00		NON CHARGE	47.90
	1 3/4" C x 1/2 I.W.H. Stop & Waste	5.84	9/27/57		Labor	4.63
	1 3/4" C 3 part union	2.27	34' - 3/4" Copper tubing			12.75
	1 Hr. Trucking @.75	.75	1 3/4" C. Corp. Cock			4.64
		47.90	1 3/4" C Curb Cock			5.94
			1 Box & Rod			4.62
						32.58
					1 1/2 Straight tailpiece	.50
					1 1/2 Offset tailpiece	.50
						33.58

DATE 3/8/59

TOWN OF LEXINGTON — BOARD OF PUBLIC WORKS

WATER DIVISION

Sketch of Service Here

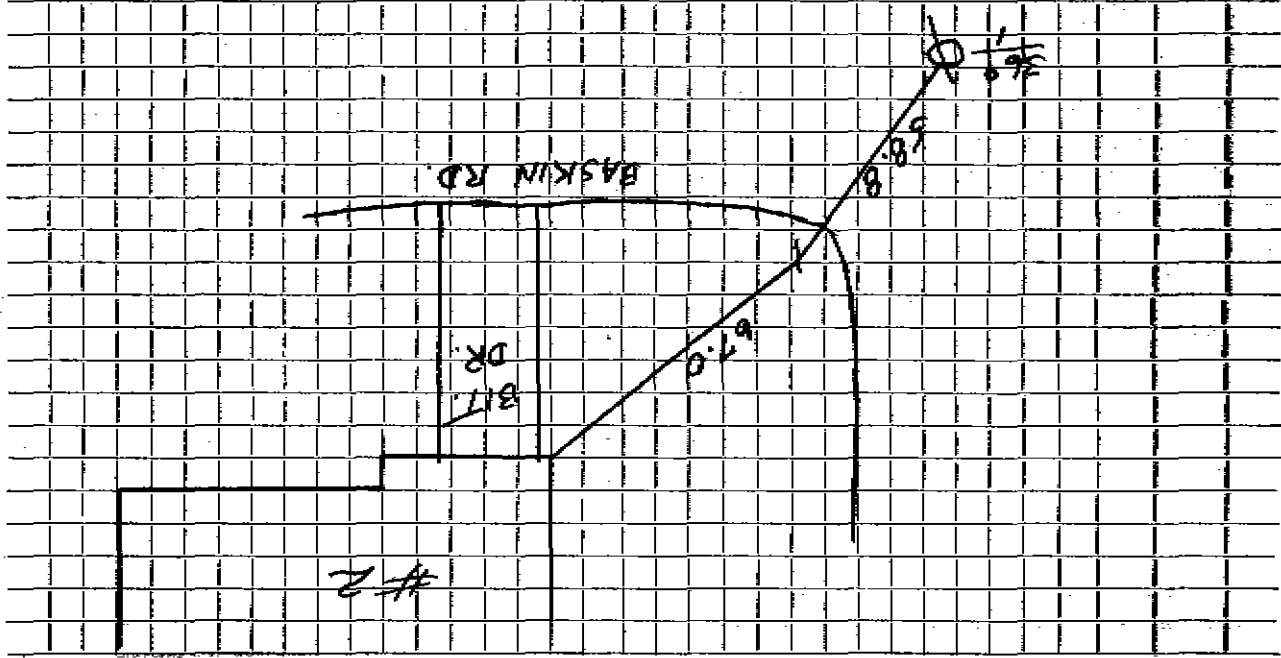

Connection made in BASKIN RD. Street. Work completed. Remarks: