

WATER SERVICE RECORD

Name **Richard Magnanti**

Service No.

4712
6243
6

Address **20 Baskin Road**

Location **Lot 10**

--Repair--Renewal--New Service

Comm. 6-2-58


Date	Material	Amount	Total	Date	Amount
3/14/58	Labor	3 71		1-14-58	Deposit \$ 50 00
	10% overhead	37	4 08	6-2-58	Refund 19 86
	55' - 3/4" Copper tubing @ .37		20 35		NON CHARGE \$ 30 14
	1 - 3/4" Cx 1/2 I.W.H. Stop & Waste		4 96	9/27/57	Labor 4 63
	1 hr. Trucking		75	38' - 3/4" Copper tubing	14 25
			30 14	1 3/4" C Corp Cock	4 64
				1 3/4" C Curb Cock	5 94
				1 Box & Rod	4 62
					34 08
				3/14/58 - 1 1/2 Straight tailpiece	50
				1 1/2 Offset tailpiece	50
					35 08

DATE 3/8/59

TOWN OF LEXINGTON — BOARD OF PUBLIC WORKS

WATER DIVISION

Sketch of Service Here

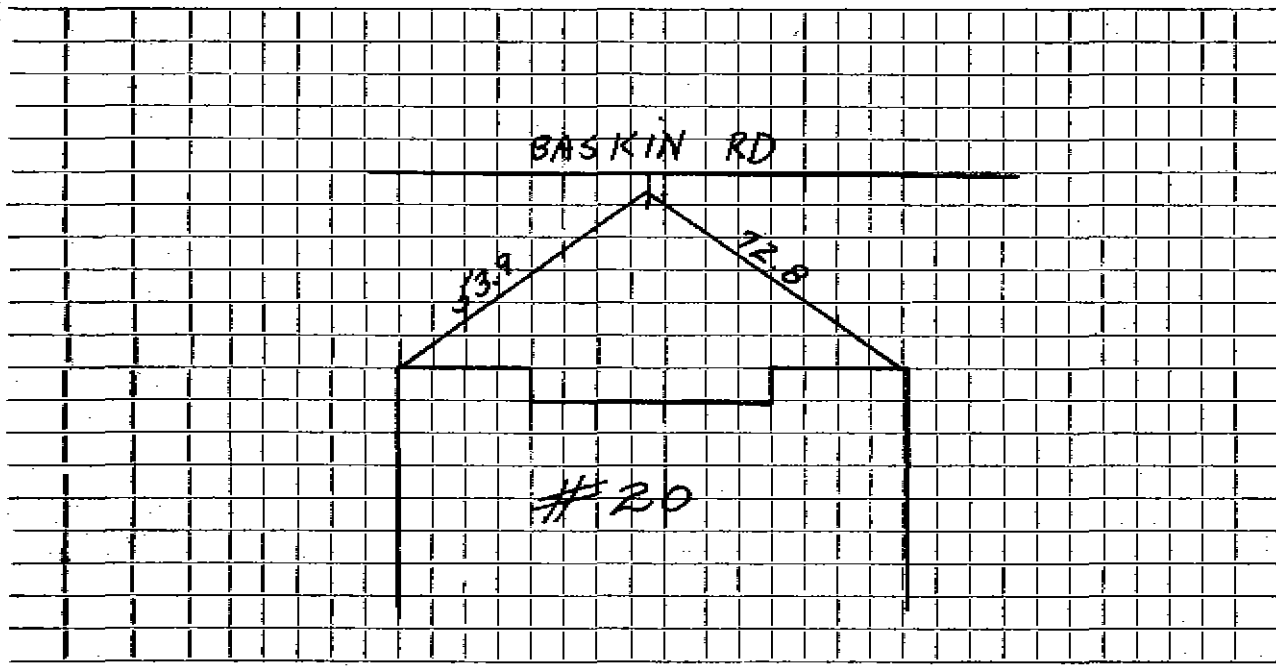

Connection made in . . . BASKIN RD . . . Street. Work completed

Remarks:
.
.