

WATER SERVICE RECORD

#3043

Name Lexington Development Corp.

Service No. 7

Address 21 Baskin Road

Location Lot 15

Repair—Renewal—New Service


Comm 5-4-59

Date	Material	Amount	Total	Date	Amount	
3-24-59	Labor	1 85		3-23-59	Deposit	50 00
	10% O. H.	19	2 04	3-24-59	Return	26 71
40'	3/4" Copper Tubing @.3666		14 66		NON CHARGE	2.3 29
1	3/4" Cx 1/2 I.W.H. Stop & Waste		5 84	9/27/57	Labor	4 64
1	Hr. Trucking @.75		75	12' - 3/4"	Copper tubing	4 50
			23 29	1 3/4"	C Corp Cock	4 64
				1 3/4"	C Curb Cock	5 94
				1	Box & Rod	4 82
						24 34
				3-24-59	1 1/2 Straight Tailpiece	50
					1 1/2 Offset Tailpiece	50
						25 34

DATE 3/8/59

TOWN OF LEXINGTON — BOARD OF PUBLIC WORKS
WATER DIVISION

Sketch of Service Here

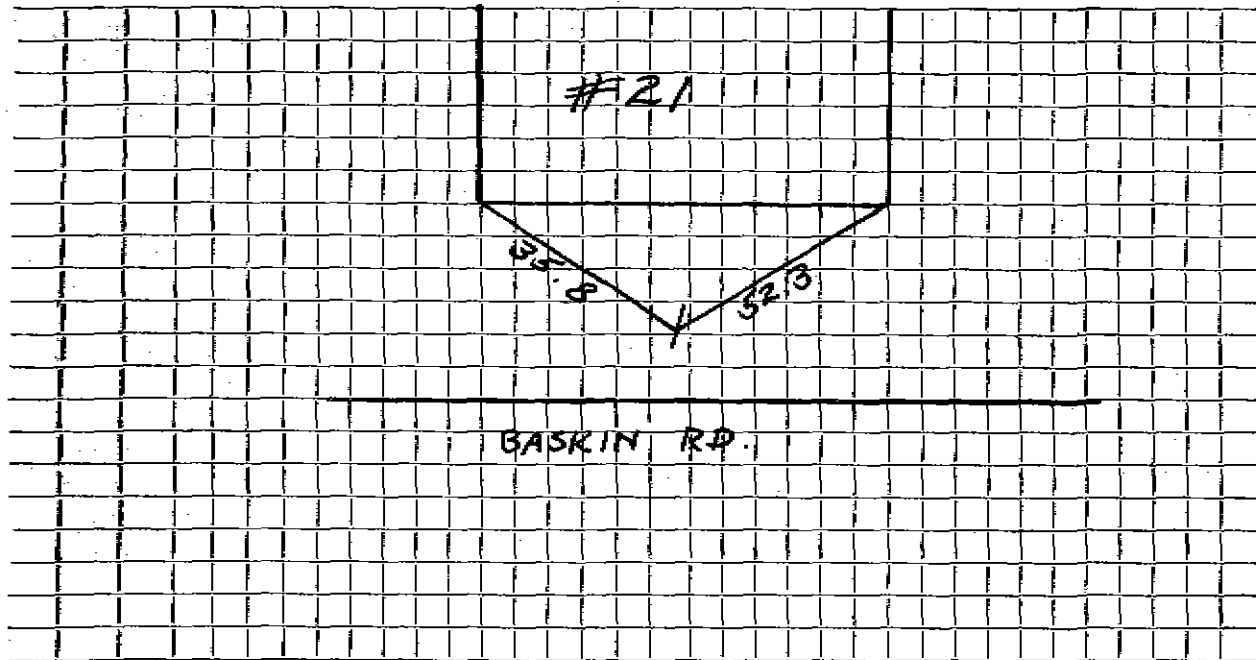

Connection made in BASKIN RD. Street. Work completed

Remarks:
.....
.....