

WATER SERVICE RECORD

# 823

Name Frank E. Dea

Service No. 254

Address 22 Baskin Road

Location Lot 11

-Repair--Renewal--New Service

Comm. 2/16/59


Date	Material	Amount	Total	Date		Amount
11/25/58	Labor	3 70		11/12/58	Deposit	\$ 50 00
	10% overhead	37	4 07	2/16/59	Refund	17 14
	60' - 3/4" Copper tubing @ .37		22 20		NON CHARGE	\$ 32 86
	1 - 3/4" Cx 1/2 I.W.H. Stop & Waste		5 84	9/27/57	Labor	4 63
	1 hr. Trucking		75	36' - 3/4" Copper tubing		13 50
			32 86	1 3/4" C Corp Cock		4 64
				1 3/4" C Curb Cock		5 94
				1 Box & Rod		4 62
						33 33
				1 - 1/2 Offset tailpiece		50
				1 - 1/2 Straight tailpiece		50
						34 33

DATE 3/8/59

TOWN OF LEXINGTON — BOARD OF PUBLIC WORKS

WATER DIVISION

Sketch of Service Here

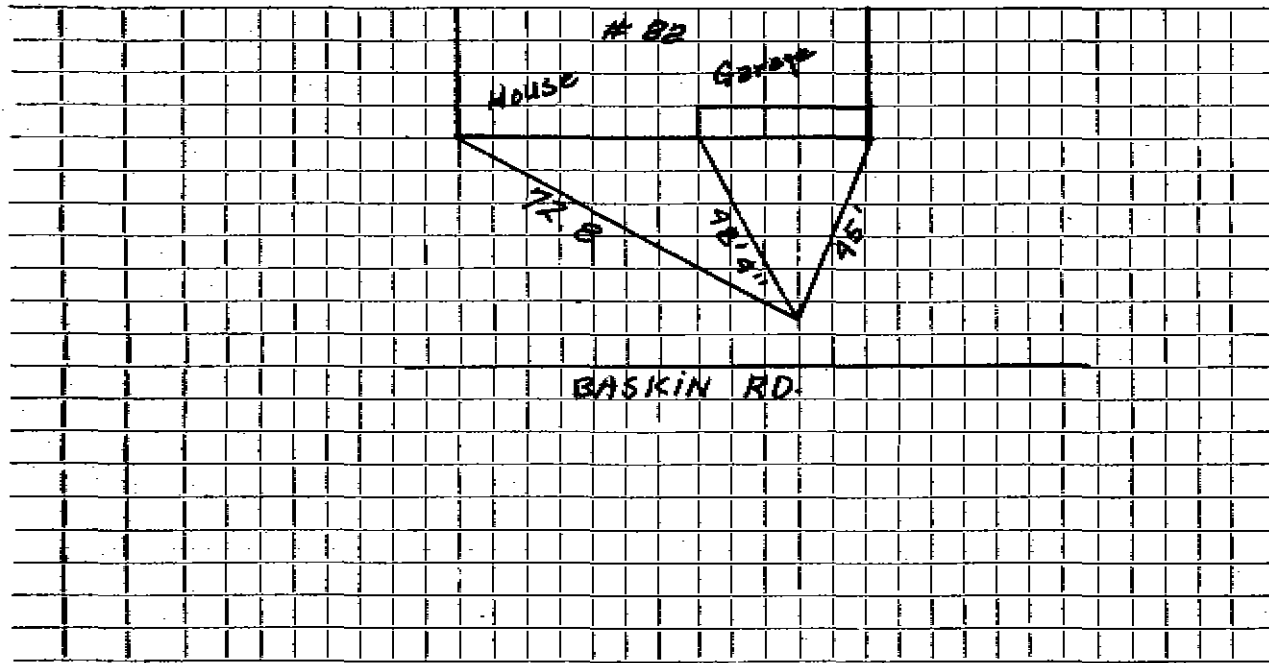

Connection made in BASKIN RD. Street. Work completed .....

Remarks: .....