

WATER SERVICE RECORD

3681

Name Richard Magnanti

Service No. 163

Address 23 Baskin Road

Location Lot 14

~~XXXXX XXXXX~~ - New Service

Comm 12-31-58


Date	Material	Amount	Total	Date	Amount
8-2-58	Labor	3.70		7-31-58	35.10
	10% O.H.	.37	4.07	12-31-58	6.85
47	3/4" Copper tubing @.37		17.39		28.95
1	3/4" C x 1/2 I.W.H. Stop & Waste		5.84	9/27/57	4.64
1	hr. Trucking @.75		.75	15' - 3/4" Copper tubing	5.63
			28.05	1 3/4" C. Corp Cock	4.64
				1 3/4" C Curb Cock	5.94
				1 Box & Rod	4.62
					25.47
				1 1/2 Straight tailpiece	.50
				1 1/2 Offset tailpiece	.50
					26.47

Applied to SM # 155

DATE 3/8/59

TOWN OF LEXINGTON — BOARD OF PUBLIC WORKS
WATER DIVISION

Sketch of Service Here

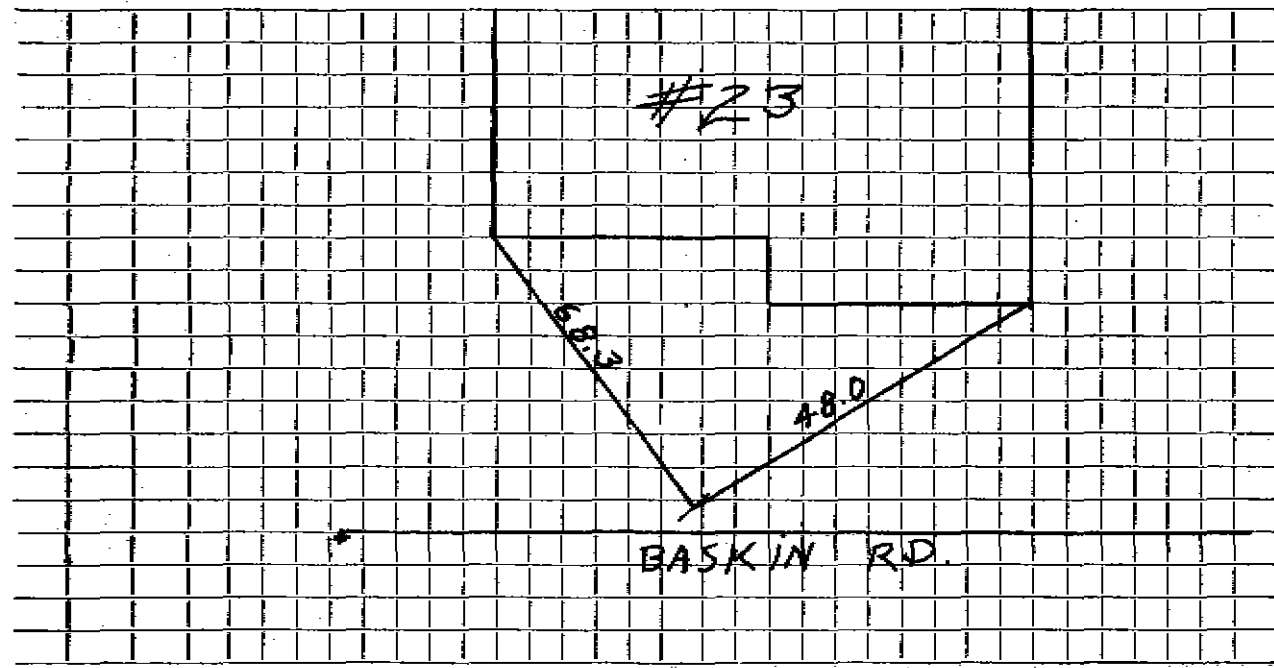

Connection made in BASKIN RD. Street. Work completed

Remarks:
.....
.....