


DATE 3/8/59

TOWN OF LEXINGTON — BOARD OF PUBLIC WORKS

WATER DIVISION

Sketch of Service Here

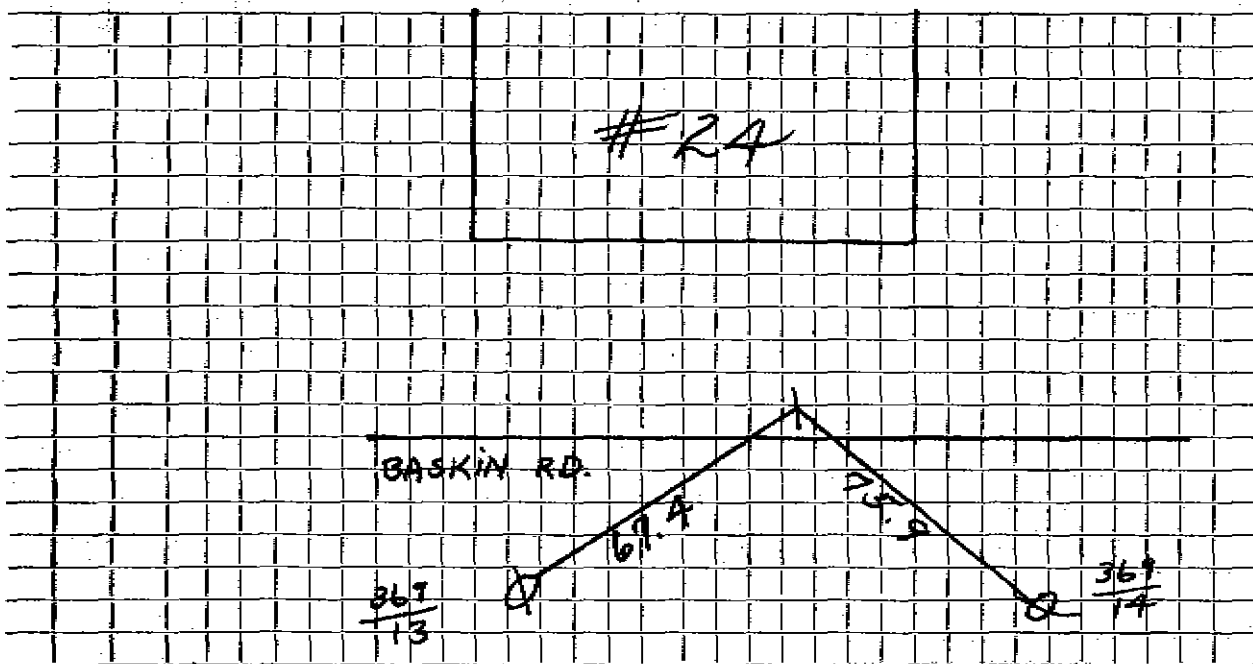

Connection made in .. BASKIN.. RD..... Street. Work completed

Remarks: Shut. o. F. in Driveway under Ho. f. Top Per. over
9-18-59. Shoe maker & Jennings Court.