

# WATER SERVICE RECORD

#2739

Name Serick Mahigien

Service No. 29

Address 25 Baskin Road

Location Lot 13

~~XXXXXXXXXX~~ New Service


*Comm 5-22-63*

Date	Material	Amount	Total	Date	Description	Amount
<u>4-6-63</u>	Labor	2.57		<u>5-6-63</u>	Deposit	12.00
	10% O.H.	.26	2.83			
<u>6-2</u>	OWNER INSTALLED COPPER				NON CHARGE	
<u>1</u>	3/4" C x 1/2" I.W.H. Stop & Waste		6.17	<u>9/27/57</u>	Labor	4.64
<u>1</u>	hr. Trucking @3.00		3.00	<u>17' - 3/4"</u>	Copper tubing	6.38
			12.00	<u>1 3/4"</u>	C Corp Cock	4.64
				<u>1 3/4"</u>	C Curb Cock	5.94
				<u>1</u>	Box & Rod	4.62
						26.22
				<u>1</u>	1/2 Straight tailpiece	.50
				<u>1</u>	1/2 Offset tailpiece	.50
						27.22

DATE 3/8/59

TOWN OF LEXINGTON, — BOARD OF PUBLIC WORKS  
WATER DIVISION

Sketch of Service Here

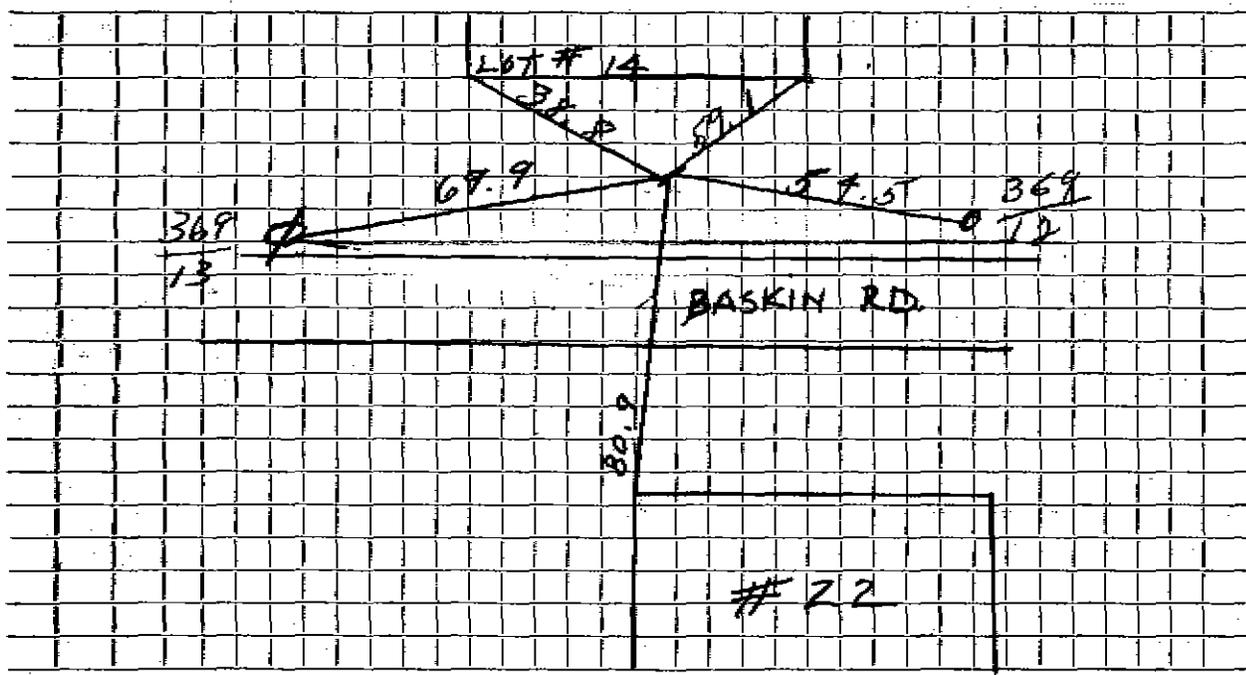

Connection made in BASKIN RD. Street. Work completed 4-5-63

Remarks: Service - curb to house installed by builder.