


DATE _____

TOWN OF LEXINGTON -- BOARD OF PUBLIC WORKS

WATER DIVISION

Sketch of Service Here

Lot 13

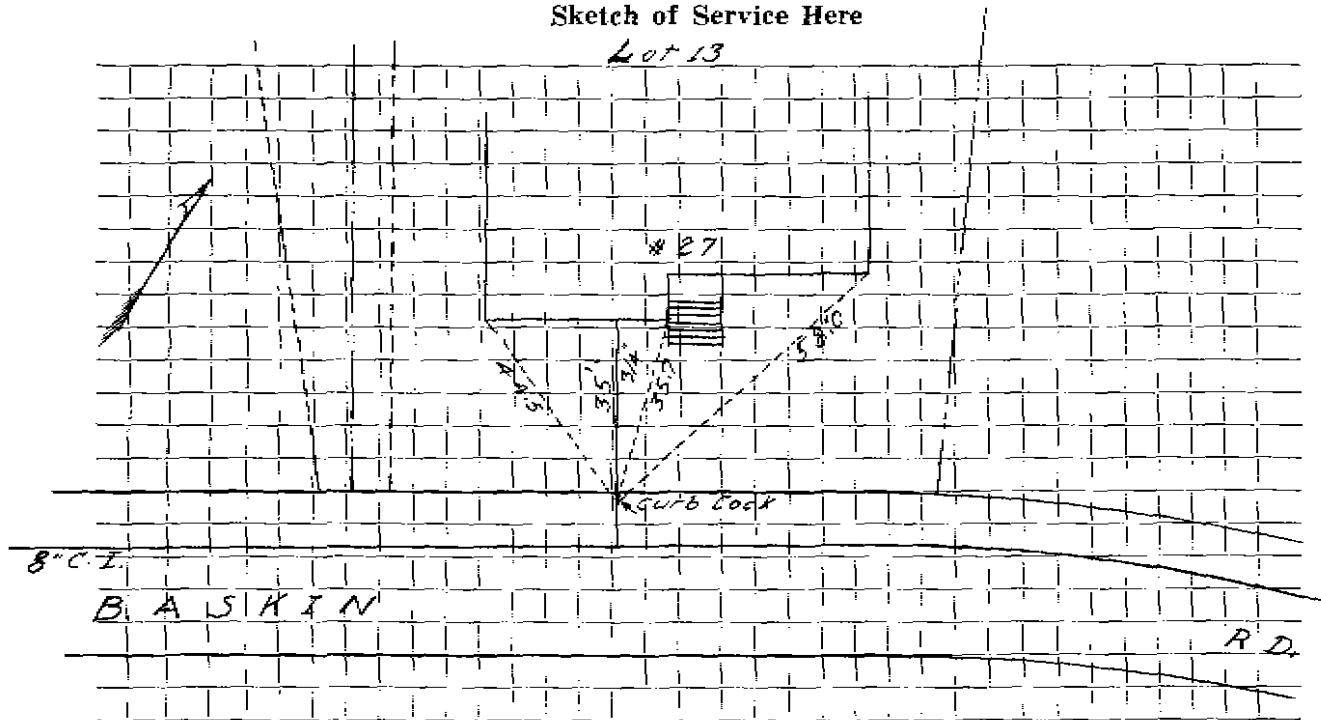

Connection made in Street. Work completed

Remarks: 8/17/94. NEW CURB COCK COMP. 1' COPPER 3/4 UNIONS