

WATER SERVICE RECORD

Name Core House Corp.

Service No. 139

Address 28 Baskin Road

Location Lot #73 Sta 17/50

~~Remit to Agency~~ New Service 20 # 8339

MAR 23 1964


Date	Material	Amount	Total	Date	Amount	
7/25/61	Labor	2 04		11-22-63	25 00	
	10% O.H.	20	2 24	3-23-64	33 98	
5'	3/4" Copper tubing @.42		2 10		51 32	
	BILL WHEN CONNECTED		4 34			
12-17-63	Labor	5 08		7/25/61	Labor	2 04
	10% O.H.	51	5 59	26'	3/4" Copper tub. @.42	10 92
60'	3/4" Copper Tubing @.42		25 20	1	3/4" C Corp Cock	4 91
1	3/4" CX 1/2 I.W.H. Stop & Waste		6 17	1	3/4" C Curb Cock	6 28
2	3/4" C3 Part Union @2.41		4 82	1	Box & Rod	4 90
1	Box & Rod		4 90			29 05
			51 02			

DATE \_\_\_\_\_

TOWN OF LEXINGTON — BOARD OF PUBLIC WORKS

WATER DIVISION

Sketch of Service Here

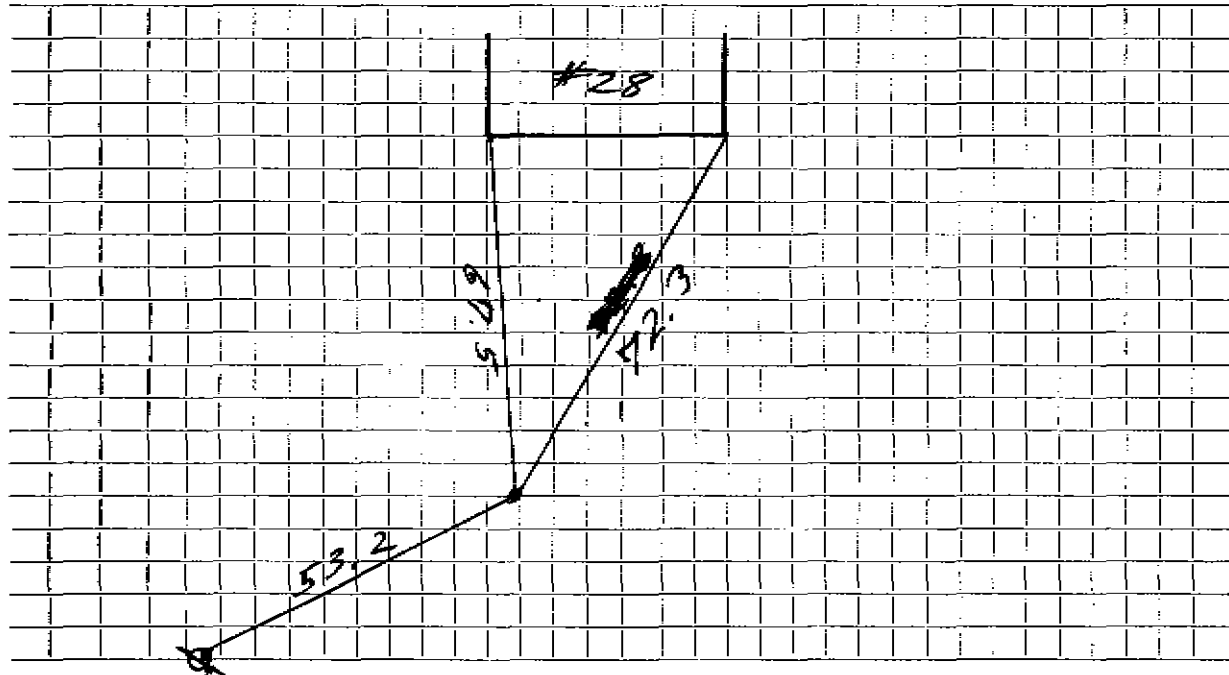

Connection made in ..... Street ..... Work completed .....

Remarks: .....  
.....  
.....