

## WATER SERVICE RECORD

Name Foley Construction Co.

Service No. 96

Address 29 Baskin Road

Location Lot #74 Sta 28/70

~~Remarks~~ New Service DeFlice Bros. Permit 7/60

COST \$33.00


Date	Material	Amount	Total	Date	Amount	
7/25/61	Labor	2 04		7-2-65	Deposit	30 93
	10% O.H.	20	2 24			
	10' 3/4" Copper tubing @ .42		4 20			
	1 Hr. Trucking @ 3.00		3 00			
	BILL WHEN CONNECTED		9 44	7/25/61	Labor	2 04
12-12-65	39' 3/4" Copper tubing			8'	3/4" Copper tubing @ .42	3 36
				1	3/4" C Corp Cock	4 91
				1	3/4" C Curb Cock	6 28
				1	Box & Rod	4 90
						21 49
						4 44
						30 93

DATE \_\_\_\_\_

TOWN OF LEXINGTON — BOARD OF PUBLIC WORKS

**WATER DIVISION**

Sketch of Service Here

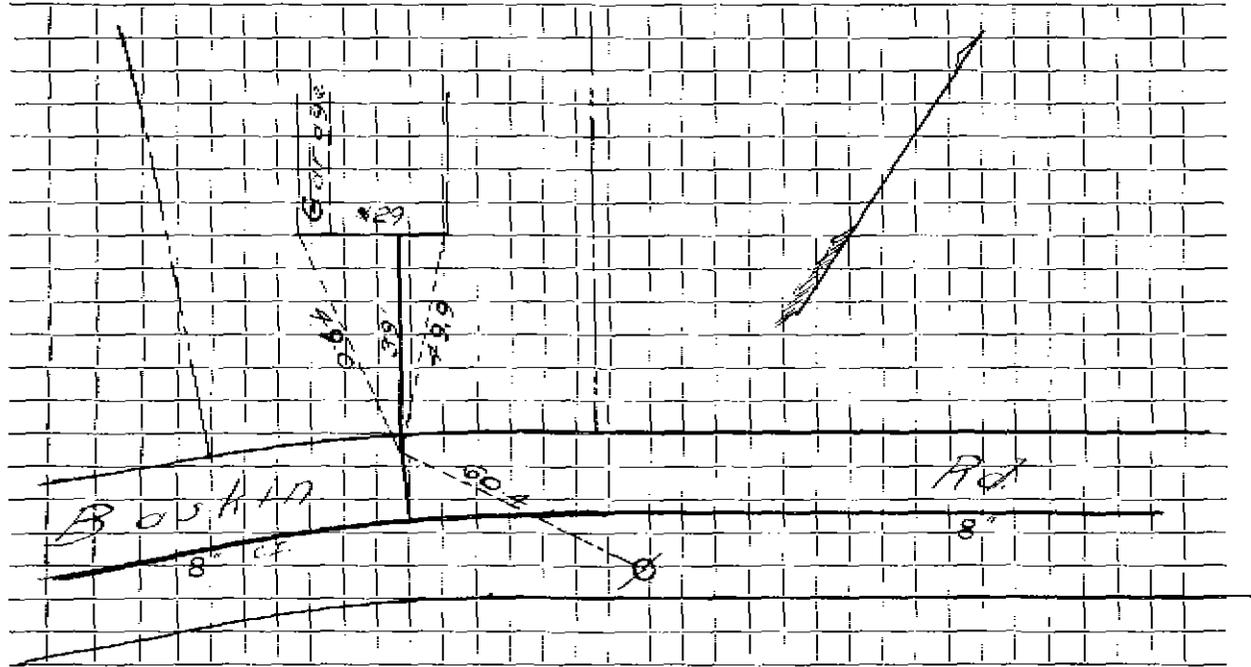

Connection made in ..... Street. Work completed .....

Remarks: .....  
.....  
.....