

WATER SERVICE RECORD

4332

Name C & C Construction

Service No. 83

Address 31 Baskin Road

Location Lot #75 Sta 18/84

~~Route #1000~~ - New Service Valeri Construct. Co. Permit #440

SEP 27 1965


Date	Material	Amount	Total	Date	Amount
7/25/61	Labor	2 04		8/16/65	31 35
	10% O.H.	20	2 24		
	11' 3/4" Copper tubing @.42		4 62		
	1 Hr. Trucking @3.00		3 00		
	BILL WHEN CONNECTED		9 86	7/25/61	Labor
			21 49		2 04
			31 35		8' 3/4" Copper tubing @.42
					3 36
					1 3/4" C Corp Cock
					4 91
8-18-65	42' 3/4" copper tubing				1 3/4" C Curb Cock
					6 28
					1 Box & Rod
					4 90
					21 49

DATE _____

TOWN OF LEXINGTON — BOARD OF PUBLIC WORKS

WATER DIVISION

Sketch of Service Here

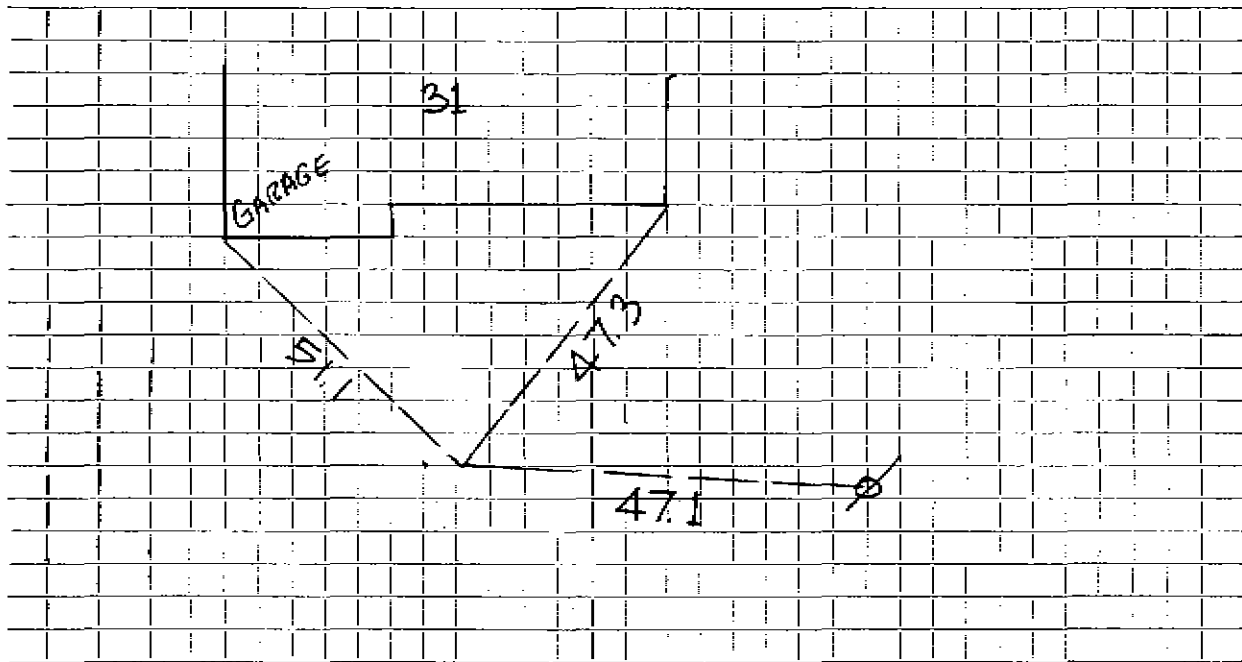

Connection made in Street. Work completed

Remarks:
.....
.....