

WATER SERVICE RECORD

Name Core House Corp.

Service No. 64

Address 32 Baskin Road

Location Lot #71 Sta 20/105

Remarks ~~REPAIR~~ - New Service


Comm 10-28-63

Date	Material	Amount	Total	Date	Material	Amount
7/26/61	Labor	2 04		7-8-63	Deposit	50 00
	10% O.H.	20	2 24	10-28-63	Refund	3 92
7'	3/4" Copper tubing @.42		2 94			46 68
	BILL WHEN CONNECTED		5 18			
7/20/63	Labor	4 28		7/26/61	Labor	2 04
	10% O.H.	43	4 71	23'	3/4" Copper tubing @.42	9 66
60'	3/4" Copper Tubing@.42		25 20	1	3/4" C Corp Cock	4 91
1	3/4" CX 1/2 I.W.H. Stop&Waste		6 17	1	3/4" C Curb Cock	6 28
2	3/4" C3 Part Union @2.41		4 82	1	Box & Rod	4 90
			46 08			27 79
				7/10/63	1 1/2 Straight Tailpiece	50
					1 1/2 Offset Tailpiece	50
						28 79

TOWN OF LEXINGTON — BOARD OF PUBLIC WORKS

WATER DIVISION

Sketch of Service Here

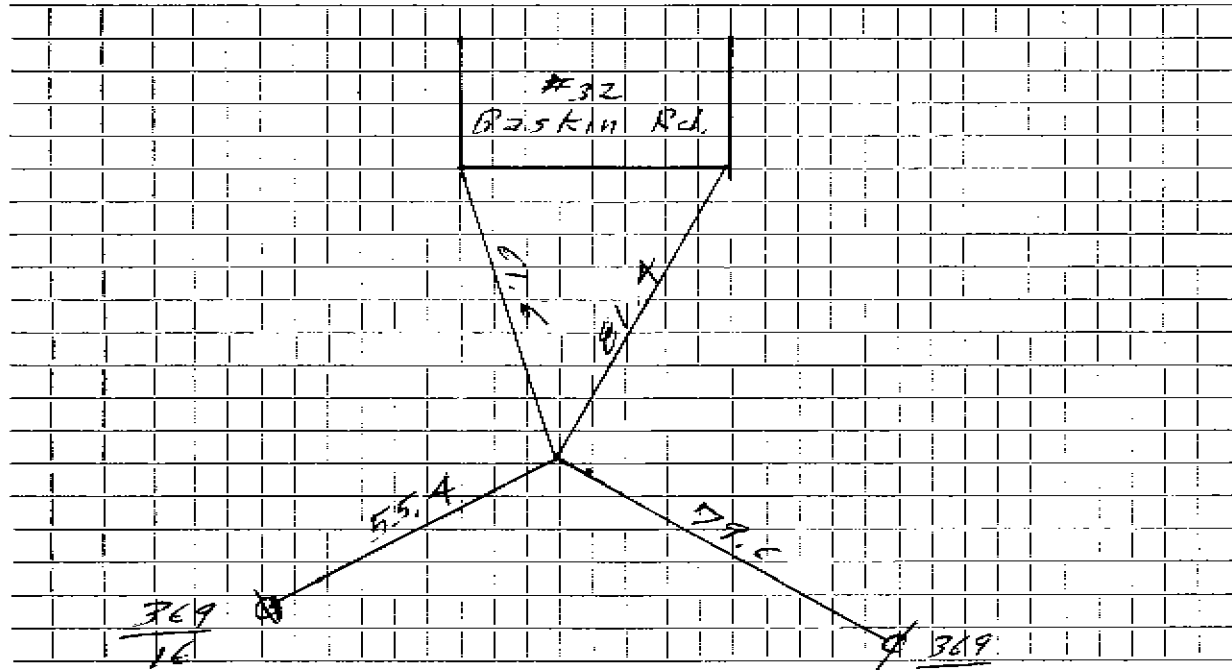

Connection made in Street. Work completed
17

Remarks:
.....
.....