

## WATER SERVICE RECORD

#6318

Name Ernest Outhet

Service No. 125

Address 34 Baskin Road

#7284

Location Lot #70 Sta 21/29

Remarks ~~Revised~~ New Service

W OFF 8220

MAR 23 1964


Date	Material	Amount	Total	Date	Material	Amount
9/25/61	Labor	2 04		11-28-63	Deposit	100 00
	10% O.H.	20	2 24	3-23-63	Returned	49 15
12'	3/4" Copper tubing @ .42		5 04			50 85
	BILL WHEN CONNECTED		7 28			
11/14/63	Labor	2 13		9/25/61	Labor	2 04
	10% Overhead	21	2 34	18'	3/4" Copper tubing @ .42	7 56
72'	3/4" Copper tubing @ .42		30 24	1	3/4" C Corp Cock	4 91
1	3/4" Cx 1/2 I.W.H. Stop & Waste		6 17	1	3/4" C Curb Cock	6 28
2	3/4" C 3-part Unions @ 2.41		4 82	1	Box & Rod	4 90
			50 85			25 69
				11/14/63	1 1/2 Straight tailpiece	50
					1 1/2 Offset tailpiece	50
						26 69

DATE \_\_\_\_\_

TOWN OF LEXINGTON — BOARD OF PUBLIC WORKS

**WATER DIVISION**

Sketch of Service Here

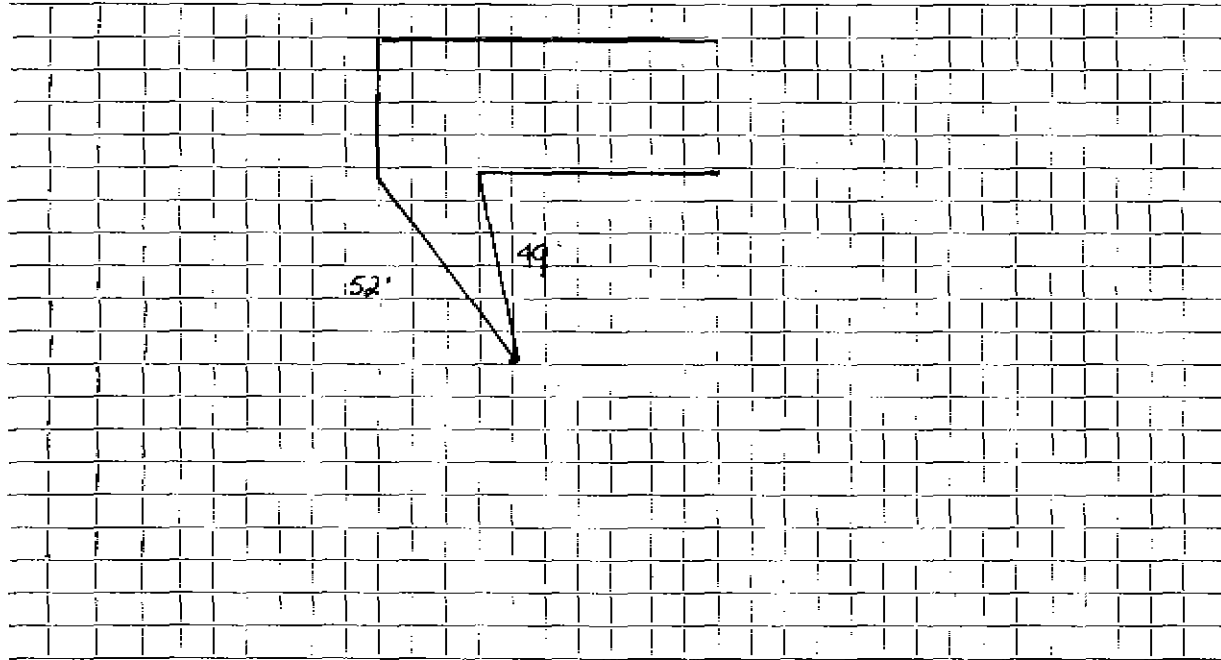

Connection made in ..... Street. Work completed .....

Remarks: .....  
.....  
.....