

**WATER SERVICE RECORD**

Name Jenkins Realty Inc.

Service No. 3

Address 35 Baskin Road

Location Lot#77 Sta. 21+35

Received by ~~General~~ New Service Dave Eagle #3591


SEP 8 1980

Date	Material	Amount	Total	Date	Material	Amount
7/26/61	Labor	2.04		<del>8/12/80</del>	Deposit	<del>38.83</del>
	10% O.H.	.20	2.24			
13'	3/4" Copper tubing @.42		5.46			
1	hr. Trucking @3.00		<u>3.00</u>		OUTSIDE	
			10.70	7/26/61	Labor	2.04
			<u>22.33</u>	10'	3/4" Copper tubing @.42	4.20
			33.03	1	3/4" C Corp Cock	4.91
10-10-80	53' 3/4" Copper tubing			1	3/4" C Curb Cock	6.28
	1 3/4" 3 part union			1	Box & Rod	<u>4.90</u>
						22.33
				10-10-80	10' 3/4" Copper tubing	

TOWN OF LEXINGTON — BOARD OF PUBLIC WORKS

**WATER DIVISION**

Sketch of Service Here

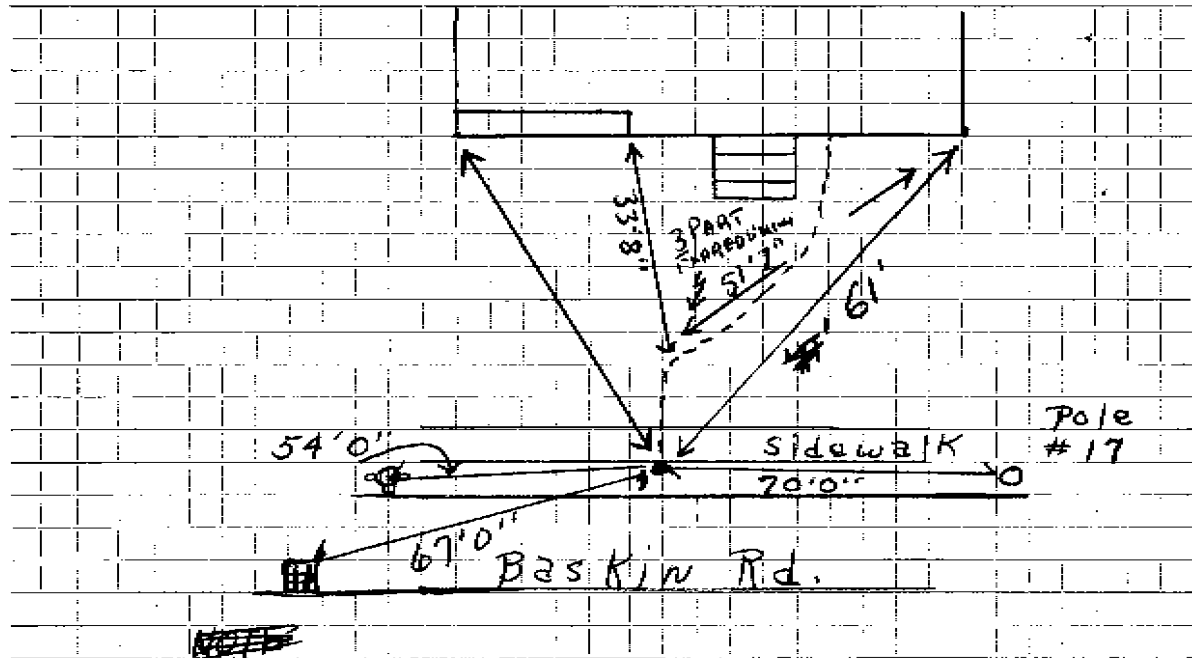

Connection made in ..... Street. Work completed .....

Remarks: .....  
.....  
.....