

WATER SERVICE RECORD

Name Interbuild, Inc.

Service No. 74

Address 36-~~2~~ Baskin Road

921

Location Lot #69 Sta 28¹³/12


~~Renewal~~ ~~Renewal~~ - New Service DeFlice Bros. Permit #52

Comm 9-21-64

Date	Material	Amount	Total	Date	Amount
7/26/61	Labor	2 04		7-15-61	21 91
	10% O.H.	20	2 24	7-14-64	8 12
	14' 3/4" Copper tubing @.42		5 88		30 03
	BILL WHEN CONNECTED		8 12		
8-12-64	88' 3/4" Copper tubing		21 71	7/26/61	2 04
			30 63	9' 3/4" Copper tubing @.42	3 78
				1 3/4" C Corp Cock	4 91
				1 3/4" C Curb Cock	6 28
				1 Box & Rod	4 90
					21 91

TOWN OF LEXINGTON — BOARD OF PUBLIC WORKS
WATER DIVISION

Sketch of Service Here

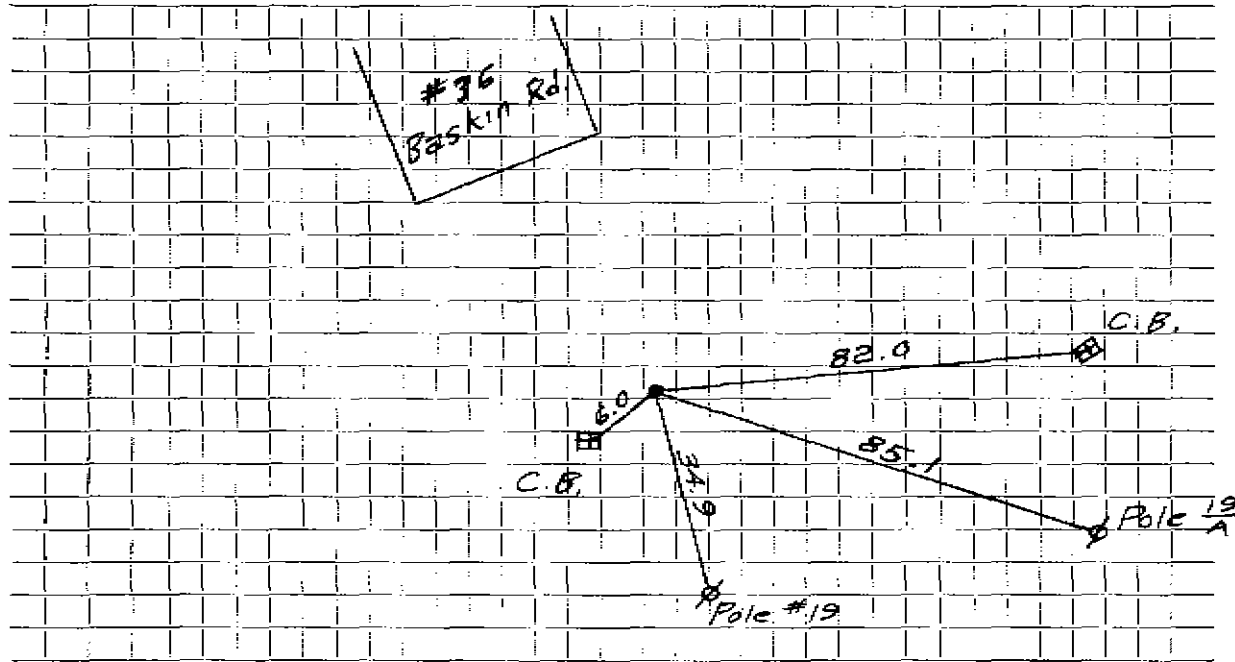

Connection made in Street. Work completed

Remarks:

.....
.....